


G-8881

T. 3 S. R. 39 E.

RECEIVED

MAY 10 1980

WATER RESOURCES DEPT.
TALEM, OREGON

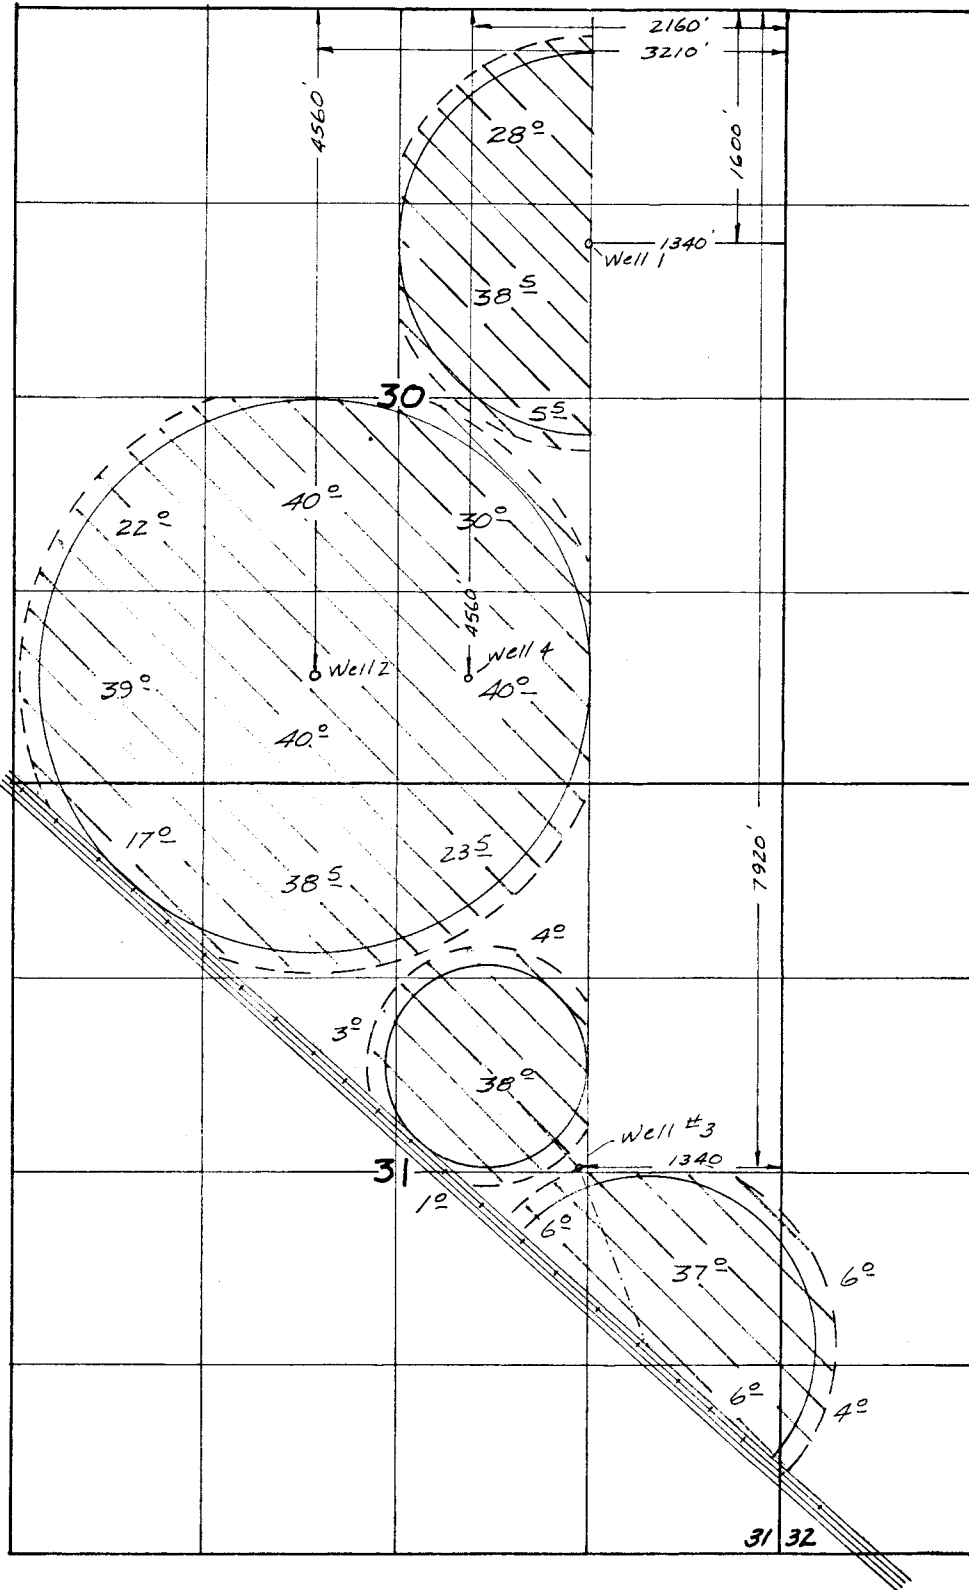

Permit No. G 8881