

PROPOSED ADDITION TO STRAWN MOBILE HOME PARK, HINES, OREGON.


June 29, 1976

Scale 1" = 50'  
Revised 5-29-80  
J.A.C.

Application No. G-9297  
Permit No. G 8909

NOTES:

Existing trailer stands are shown by broken lines, and proposed additions are shown by solid lines.  
The manhole and sump are to be standard precast manholes on poured concrete bases. Water lines are to be steel or PVC and sewer lines PVC or asbestos cement.  
The submersible sump pump is to have automatic control.

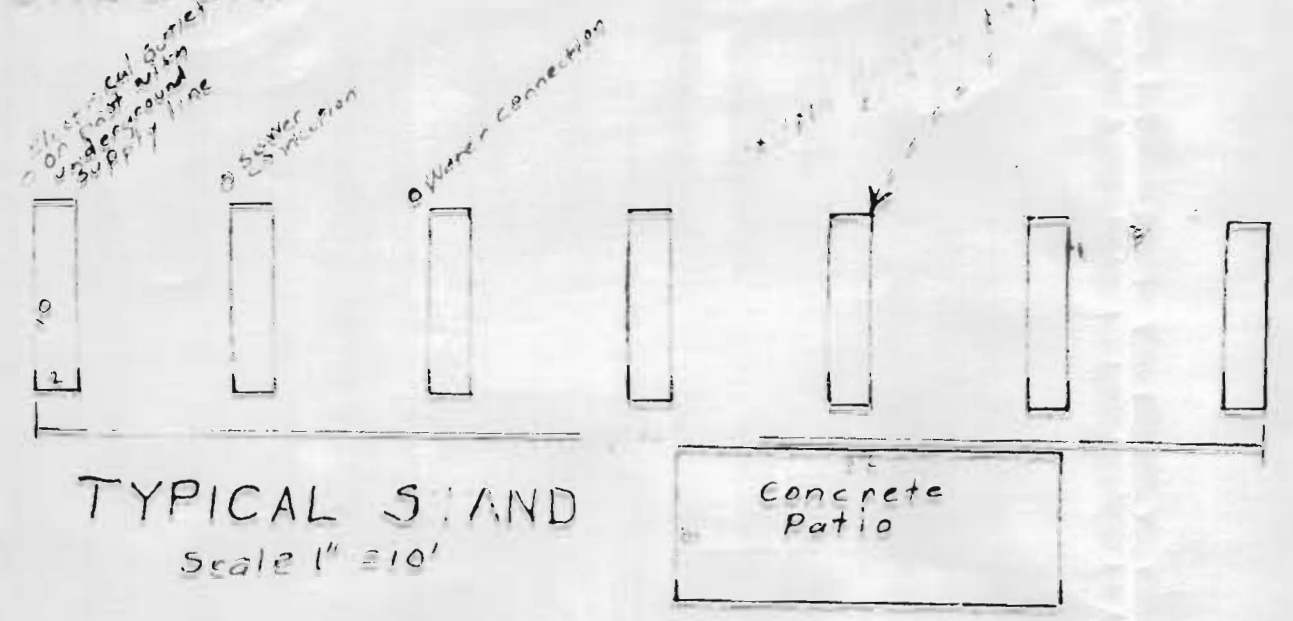

J.A.C. land

