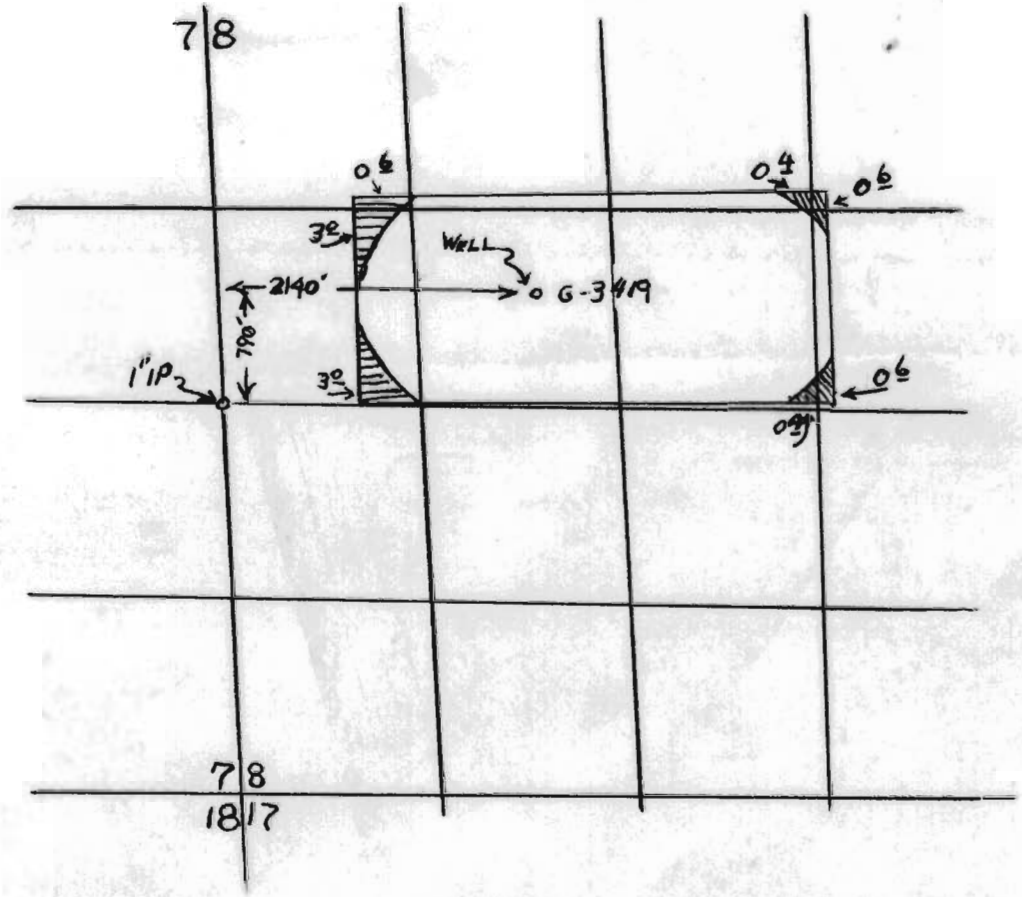

4" = 1 MILE

T24S R30E SEC. 8

~~KEN SMITH~~

J.J. PRAGGASTIS

Application No. G-9521
Permit No. G 8912

T. 24 S. R. 30 E. W. M.

T24 S R 30E

G 2363
G 3358
G 3419
G 3420
G 4233

RECEIVED
JAN 22 1980
WATER RESOURCES DEPT
SALEM, OREGON

Application No. G-9521
Permit No. G 8912

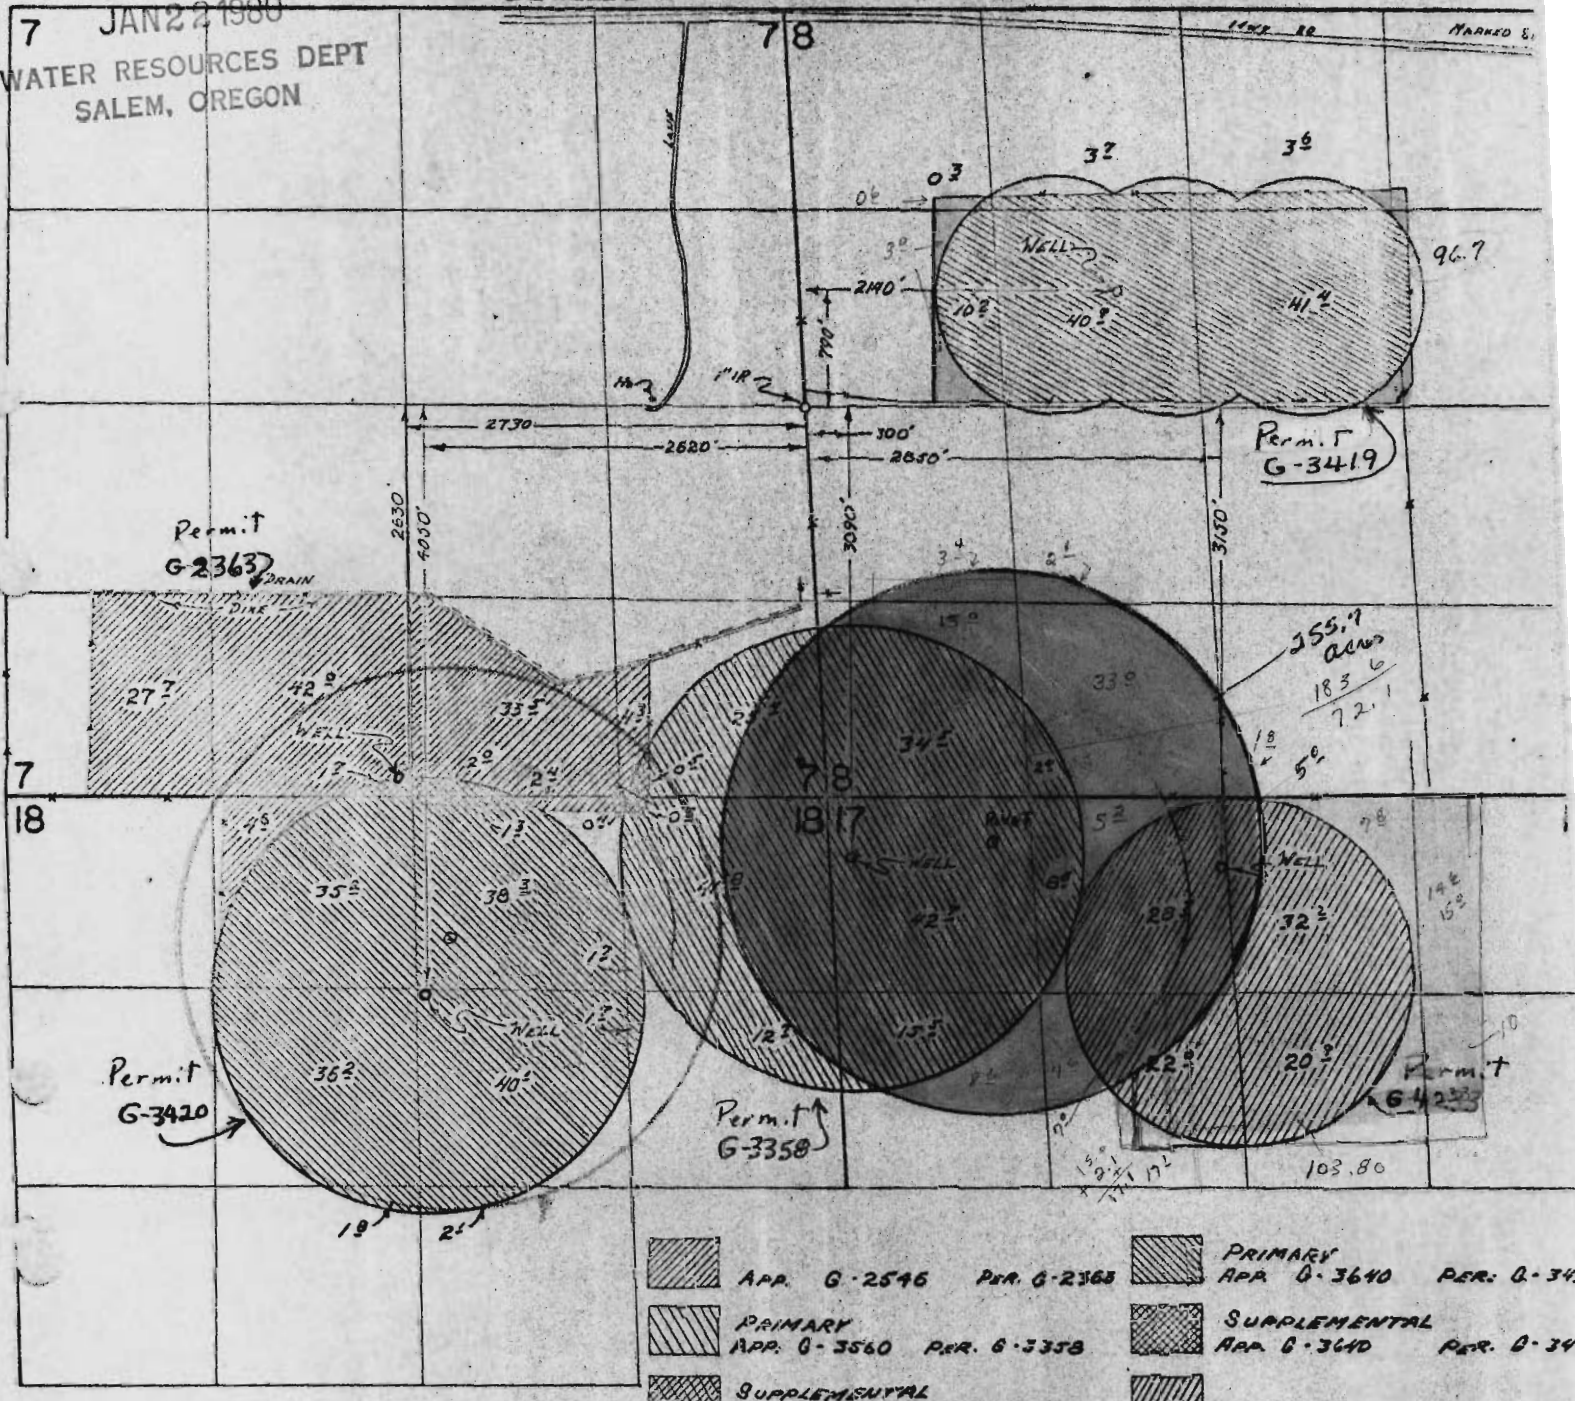

Key Title & Escrow
3975 River Rd North
Salem, Ore 97310

Donna Merzi mgr.
Escrow # 5-10850

J.J. Prappas
Ken Smith

FINAL PROOF SURVEY

ORDER

Application No. G-2546 G-3560 G-3639 G-3640 G-4491

Permit No. G-2363 G-3358 G-3419 G-3420 G-4233

ADOLF J. KISLE