


North

Found Marked Stone

FEB - 8 1994

WATER RESOURCES DEPT
SALEM, OREGON

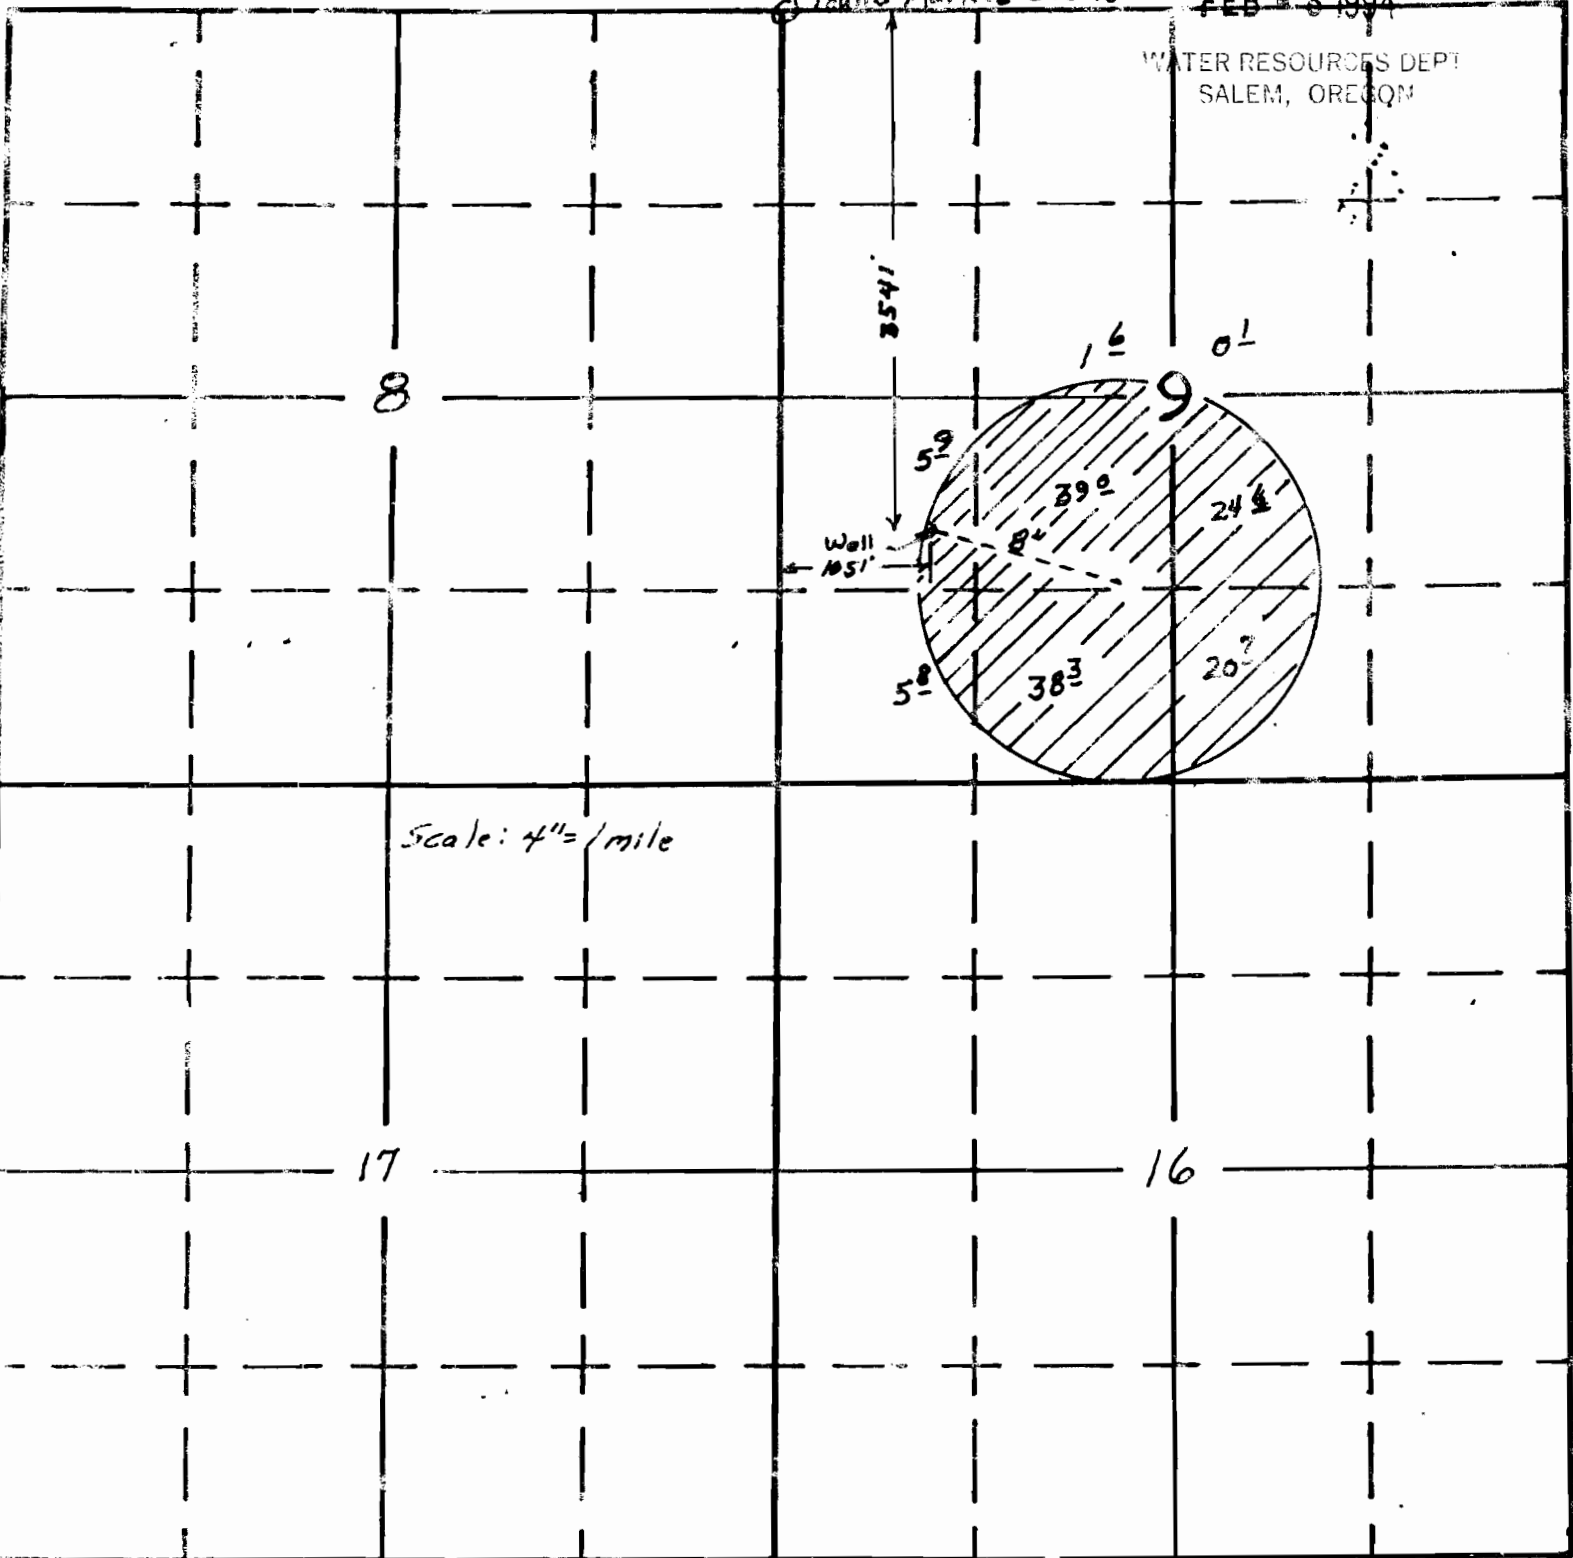

Scale: 4" = 1 mile

South

All information on this map furnished
by applicant

APPLICATION No.

PERMIT No.

Delwood Ranch Inc
199 New Delwood
Applicant

Application No.

Permit No. **G 8914**