


WATER RIGHT MAP

FOR: J. FRANK SCHMIDT, JR.
9500 S.E. 327TH AVE.
BORING, OR 97009

T 1 S, R 4 E, W. M.

SECTION 27

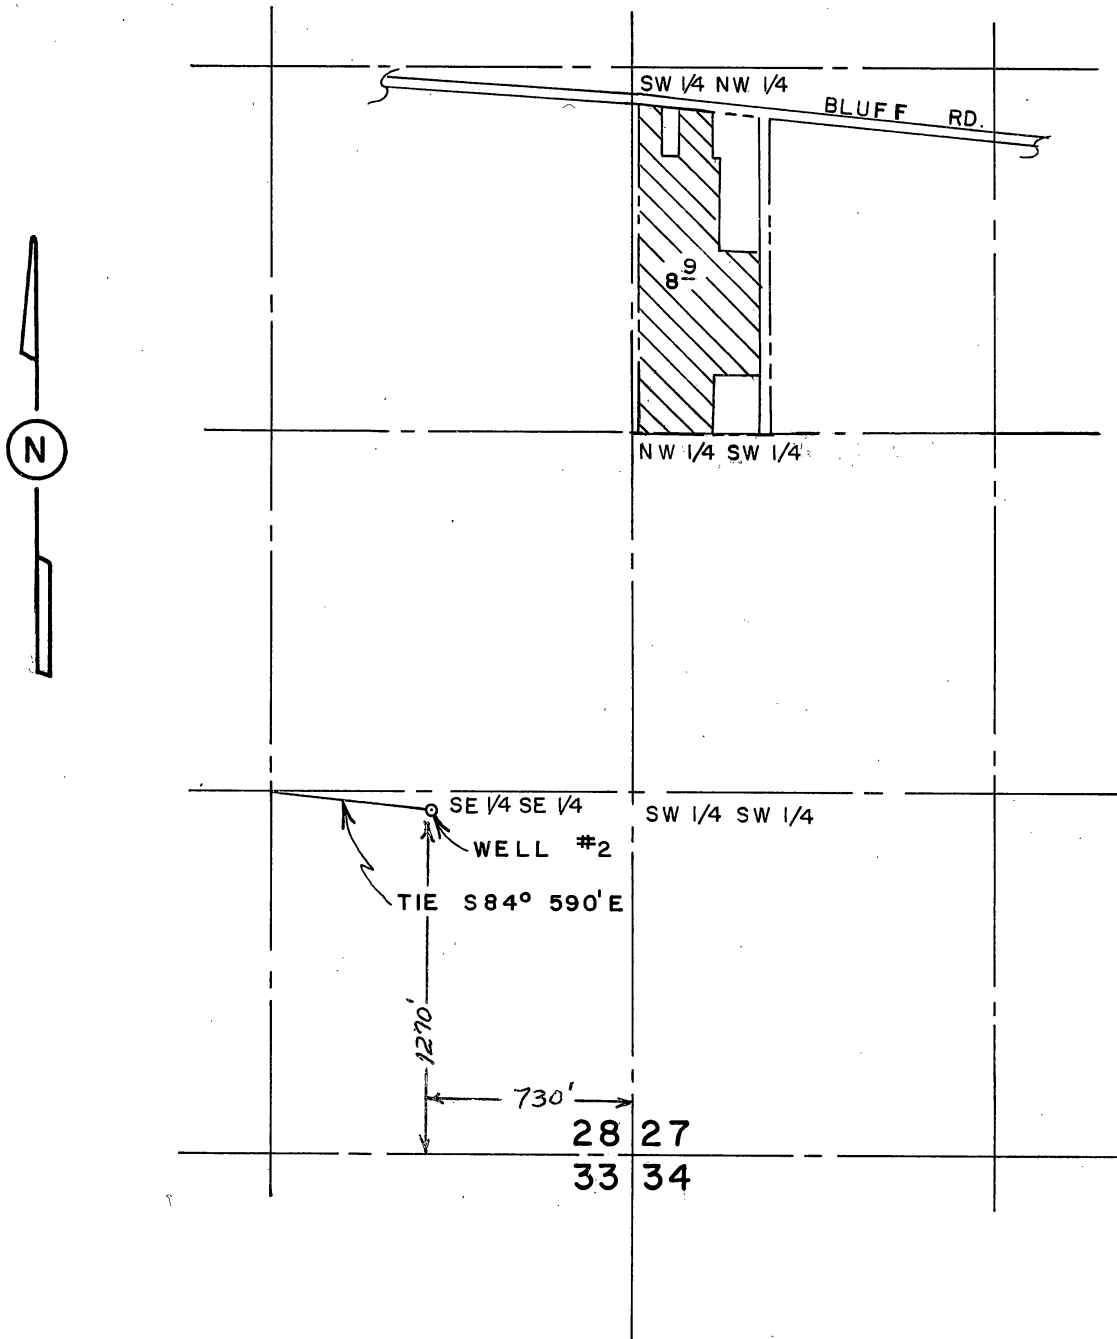

PREPARED BY P.G.E.

SCALE: 1" = 660 FT.

Application No. G-9882
Permit No. G 8925