


RECEIVED

MAR 30 1987

WM. DIST. 14
GRANTS PASS, ORE.

T.37S. R.5W. W.M.

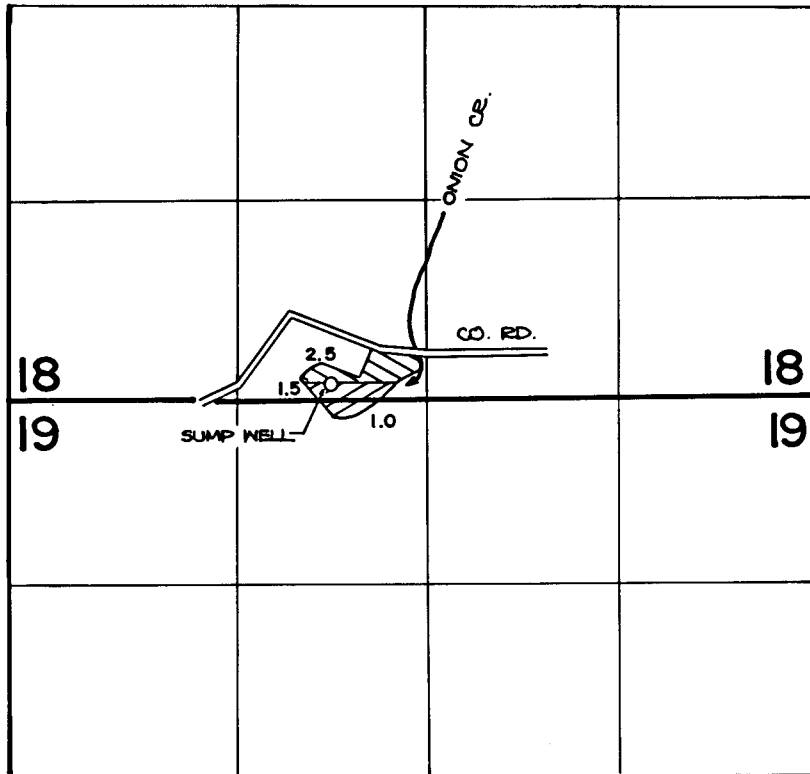

WELL IS LOCATED 110' N. AND 2200' E. FROM THE S.W. CORNER OF SECTION 18.



PRIMARY



SUPPLEMENTAL

FINAL PROOF SURVEY

UNDER

Application No. G-9514. Permit No. G-8937.
IN NAME OF

LEWIS E. HAYES

Surveyed MAY 14, 1982, by B. SUND