

SCALE

8" = 1 mi.


Tp. 26 R18

SECT. 31

WELL LOCATED
ON THE S.W. CORNER
OF THE N.E. 1/4 of
THE N.E. 1/4 of
SECT. 31, 1320'S &
1320'W of NE
COR of Sec 31

Application No. G 9758
Permit No. G 9018

31

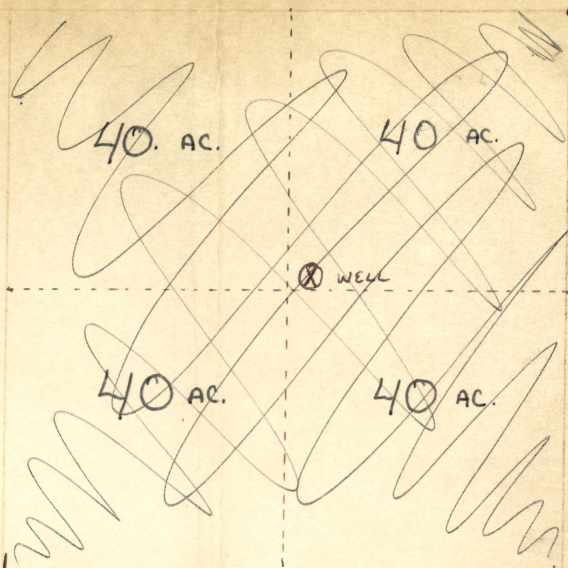

RECEIVED
SEP 30 1980
WATER RESOURCES DEPT
SALEM, OREGON

RECEIVED
JUN 3 1980
WATER RESOURCES DEPT
SALEM, OREGON