


SEC. 33 T26S. R17E. W.M.

Application No. G-9818
Permit No. G-9063

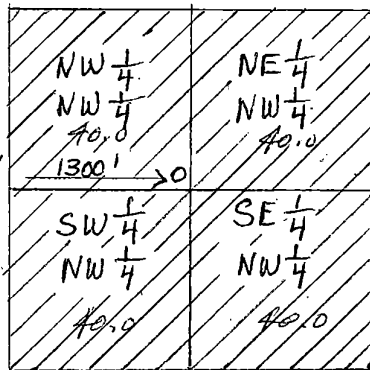

33

SCALE 4" = ONE MILE

o - WELL

RECEIVED
JUL 2 1980
WATER RESOURCES DEPT
SALEM, OREGON