


2" GAS LINE

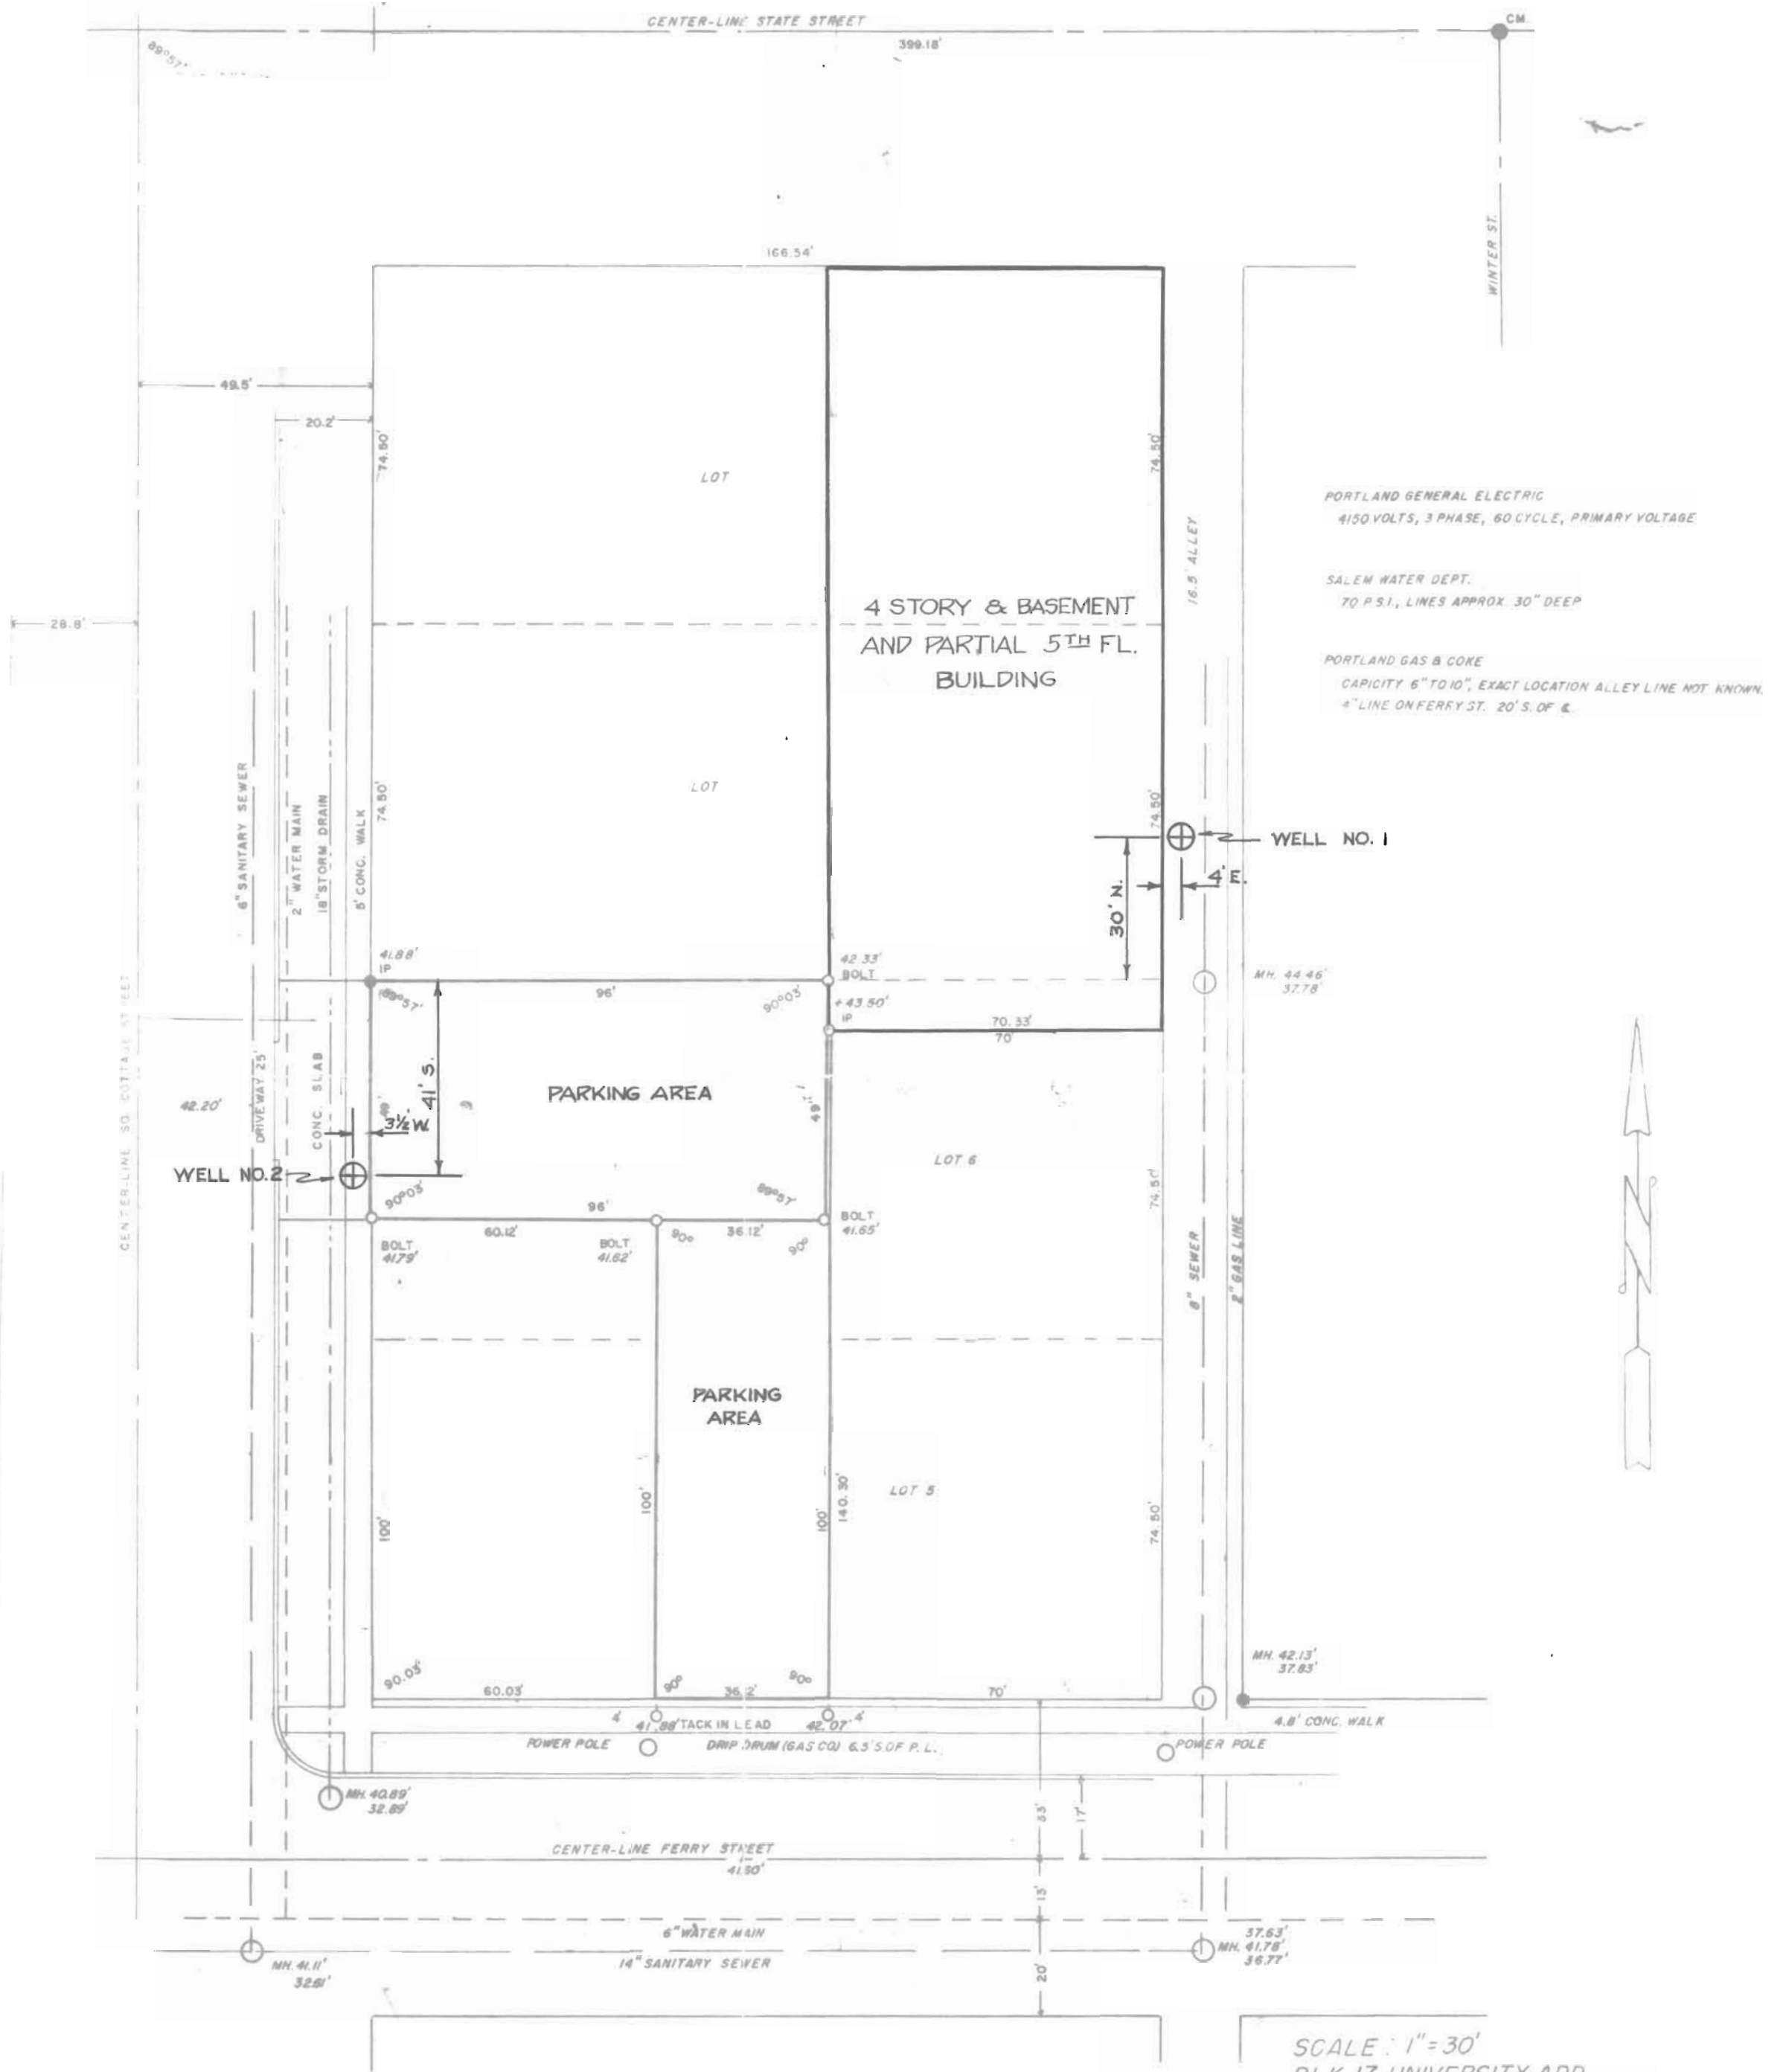

Application No. G-1038
Permit No. G-907