


T. 40 S., R. 8 W., W. M.

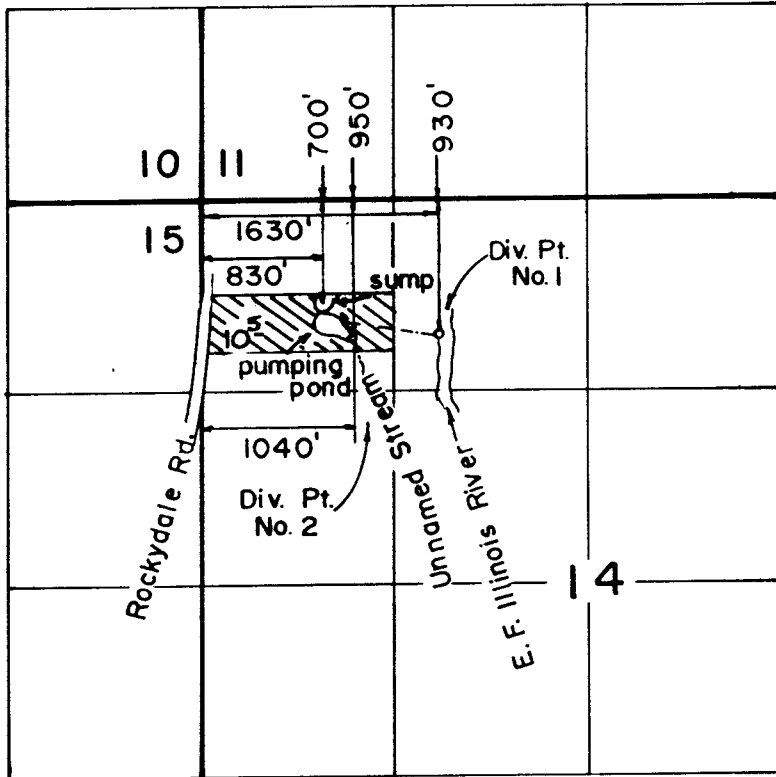

Scale: 1" = 1320'

MAY 23 1989

**FINAL PROOF SURVEY**  
UNDER

G-9830                      G-9080  
Application No. **60341** Permit No. **45180...**  
IN NAME OF

**LOTTE KERIVAN**

Surveyed **APR. 17, 1986**, by **B. S. JAMES**

4/23-199-1892

(11)