


T.26S., R.16E., W.M.

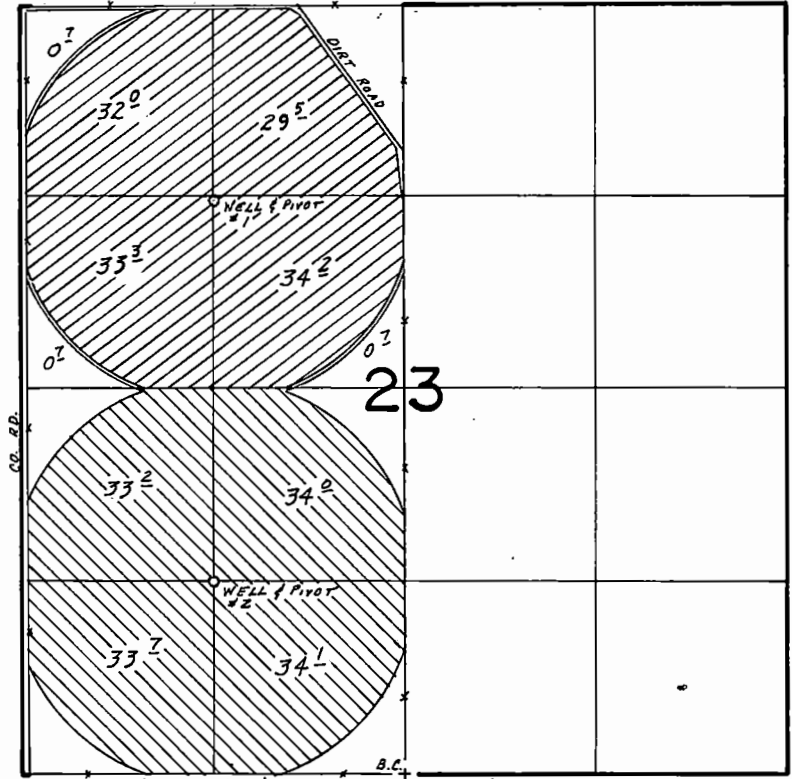

WELLS LOC: #1- 3940' N. of 1320' W., #2- 1320' N. of 1320' W., BOTH FROM S 1/4 COR. SEC. 23.

- WELL No. 1
- WELL No. 2

SCALE: 1" = 1320'

FINAL PROOF SURVEY UNDER

Application No. G-10097. Permit No. G-9126.....
IN NAME OF

.....VERL E. NOFZIGER.....

Surveyed Q.C.T..29.. 1984., by B.W..BISHOP.....