


Township 26 South; Range 16 East
 Section 26; E 1/2

(#5)

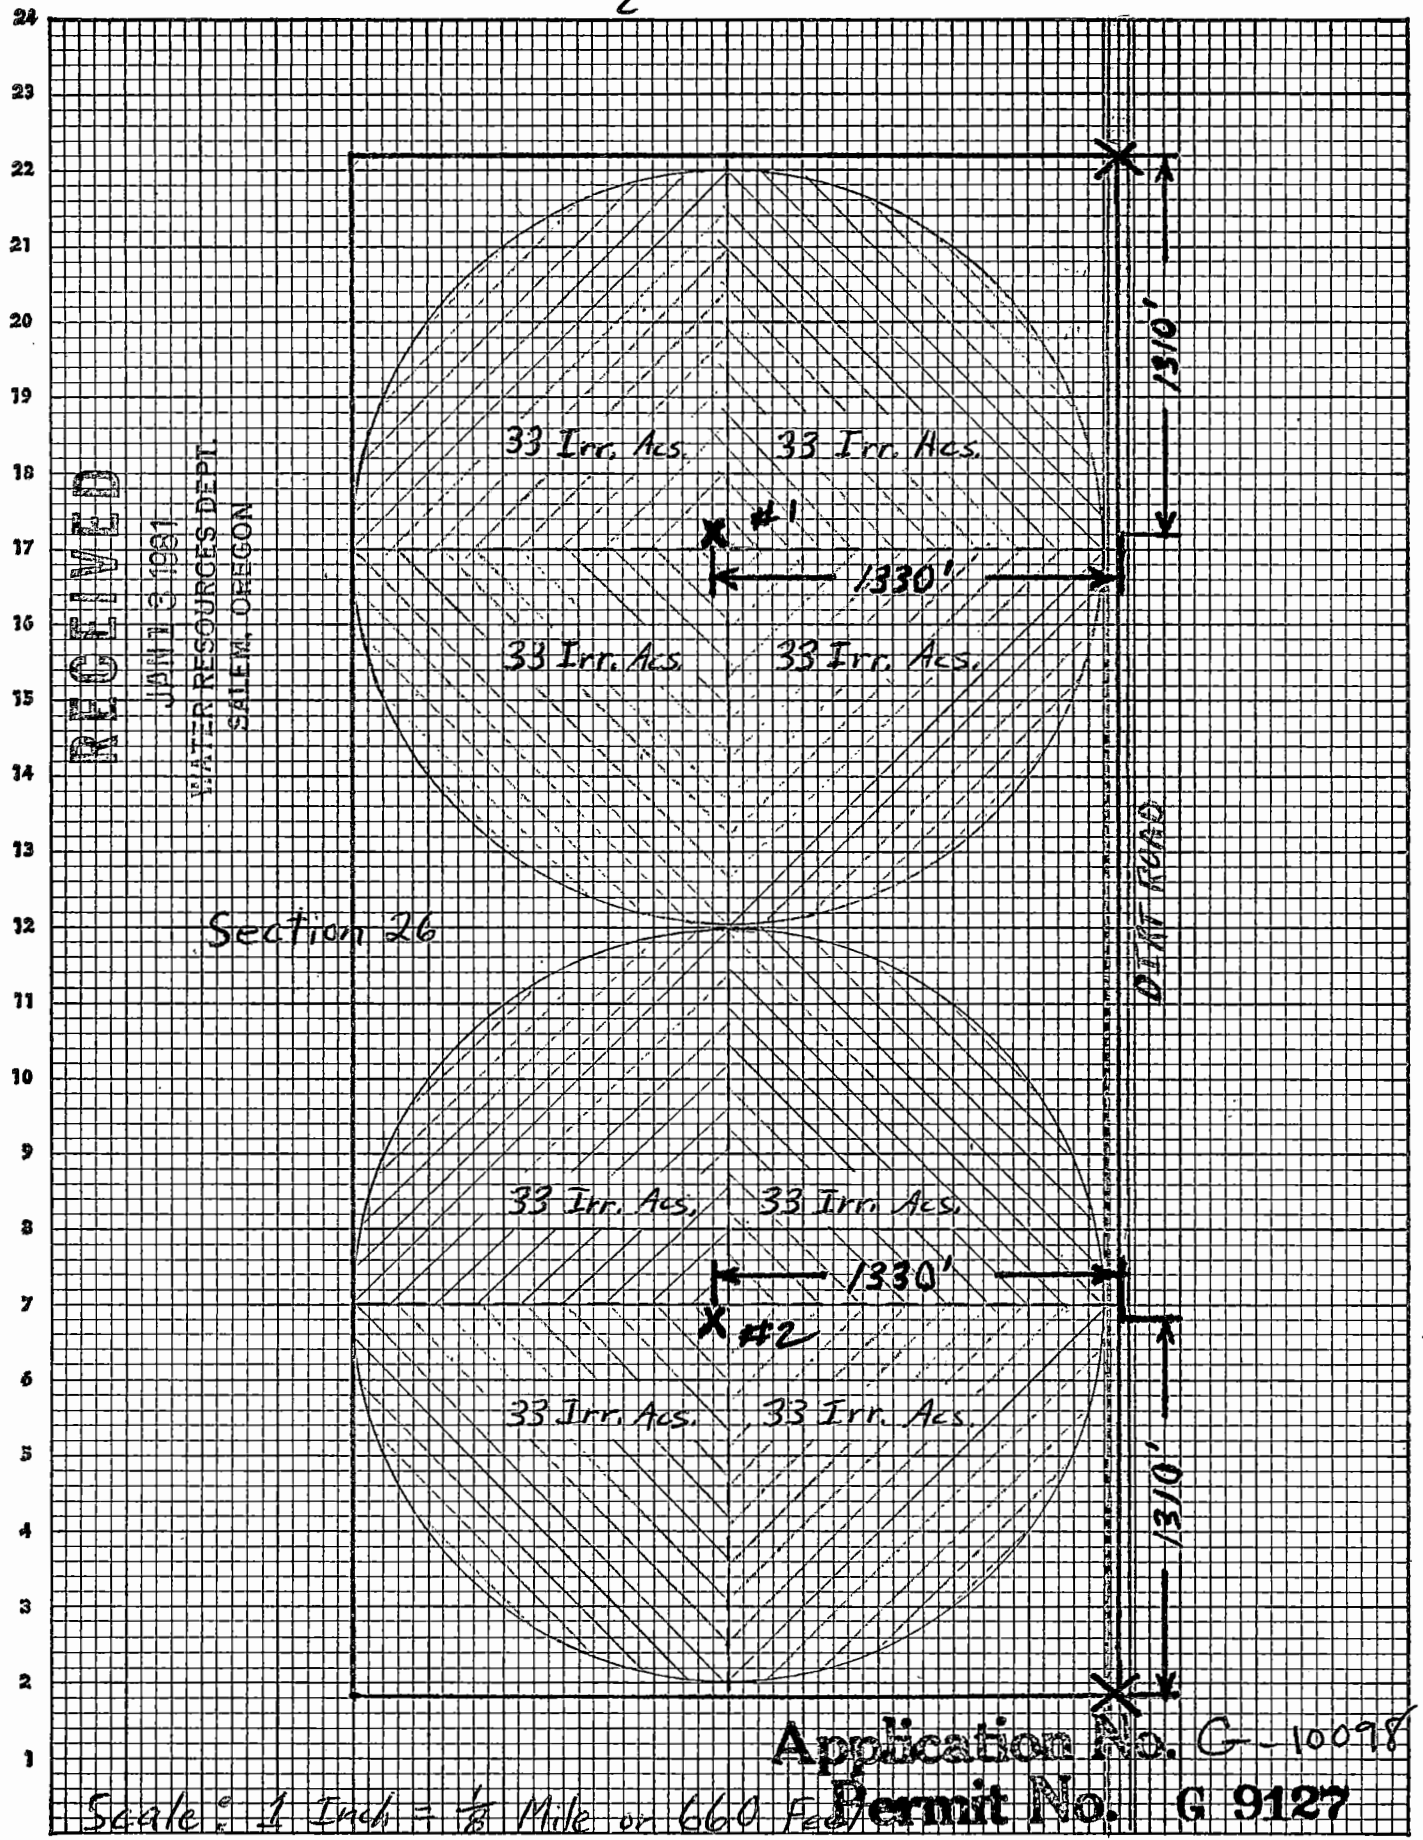

RECEIVED


WATER RESOURCES DEPT.
 SALEM, OREGON

Section 26

Application No. G-10098

Permit No. G 9127

Scale - 1 Inch = 1/8 Mile or 660 Feet



