


T.5S.R.2W.W.M.

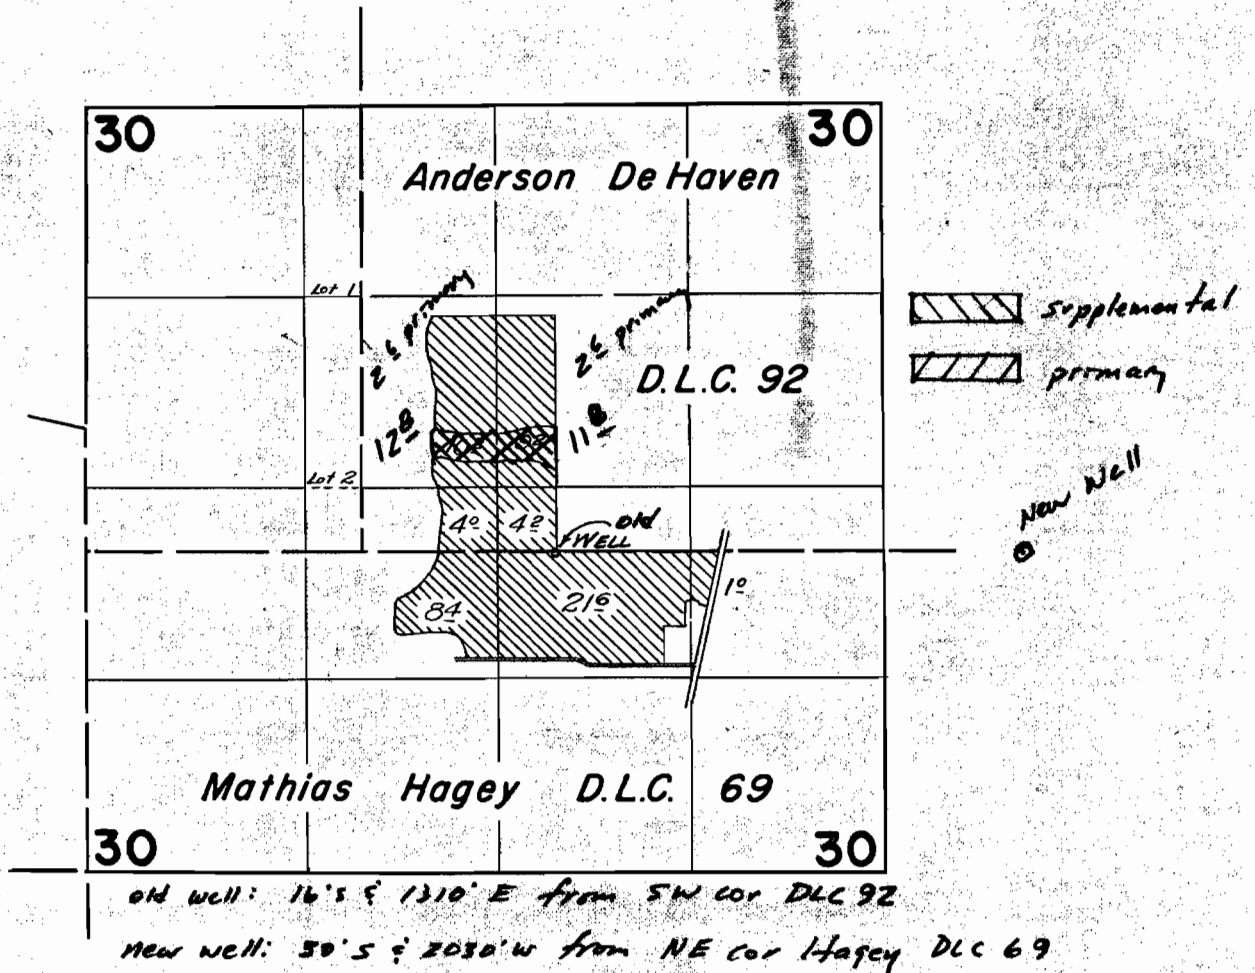

~~FINAL PROOF SURVEY~~ UNDER

Application No. ~~G-1409~~ Permit No. ~~G-1372~~
IN NAME OF

~~CARTER KEENE~~

Surveyed ~~May 27 1963~~ by ~~J. Lower~~

Application No. ~~D-10044~~
Permit No. 9151

RECEIVED
DEC 08 1980
DEPT
WATER RESOURCES
SALEM, OREGON