


T. 38 & 39 S., R. 5 W., W.M.

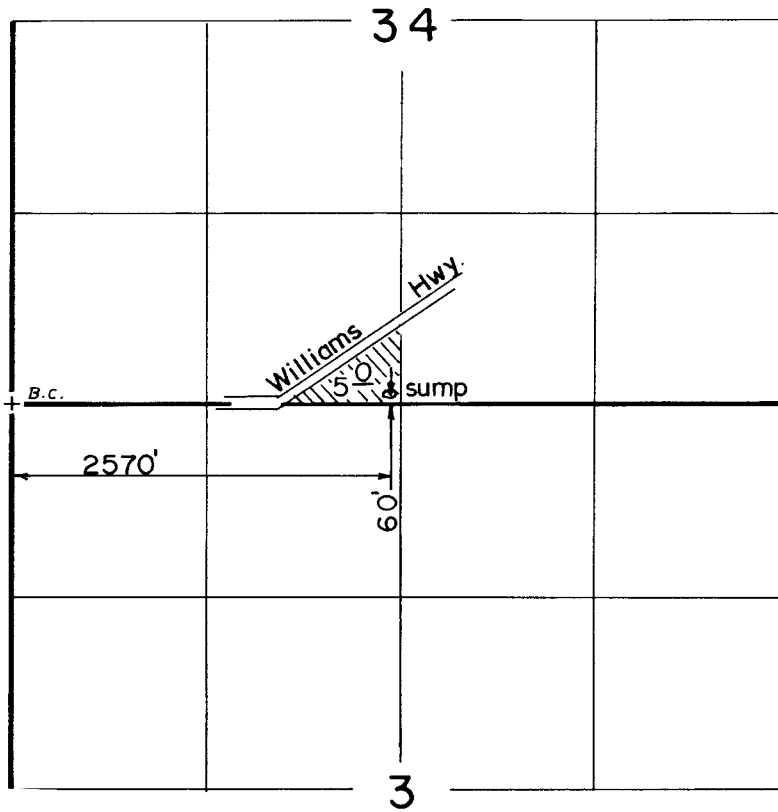

Scale: 1" = 1320'

RECEIVED

AUG 2 1991

WM. DIST. 14
GRANTS PASS, ORE.

FINAL PROOF SURVEY UNDER

Application No. G-9725 Permit No. G-9177...
IN NAME OF

.....ROGER L. PREFONTAINE.....

Surveyed JUL. 13. 19.88, by B...S.....JAMES.....