


T. 18 S. R. 46 E. W.M.

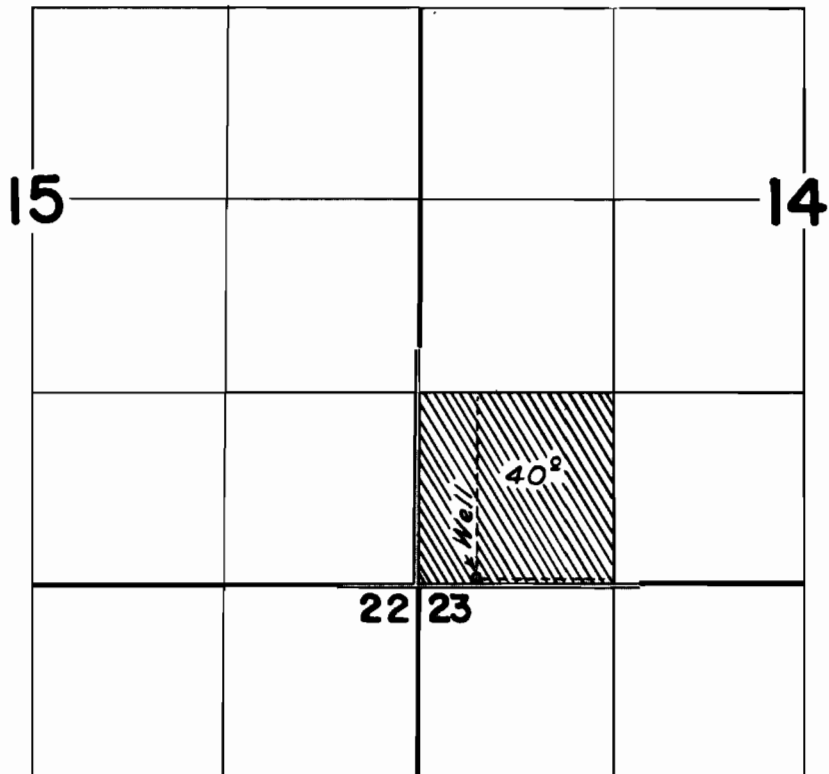

FINAL PROOF SURVEY UNDER

Application No. G-965 Permit No. G-919
IN NAME OF

LEE & LEO MONCE

Surveyed July 10, 1962, by C.R. Baker