


# T.28S., R.15E., W.M.

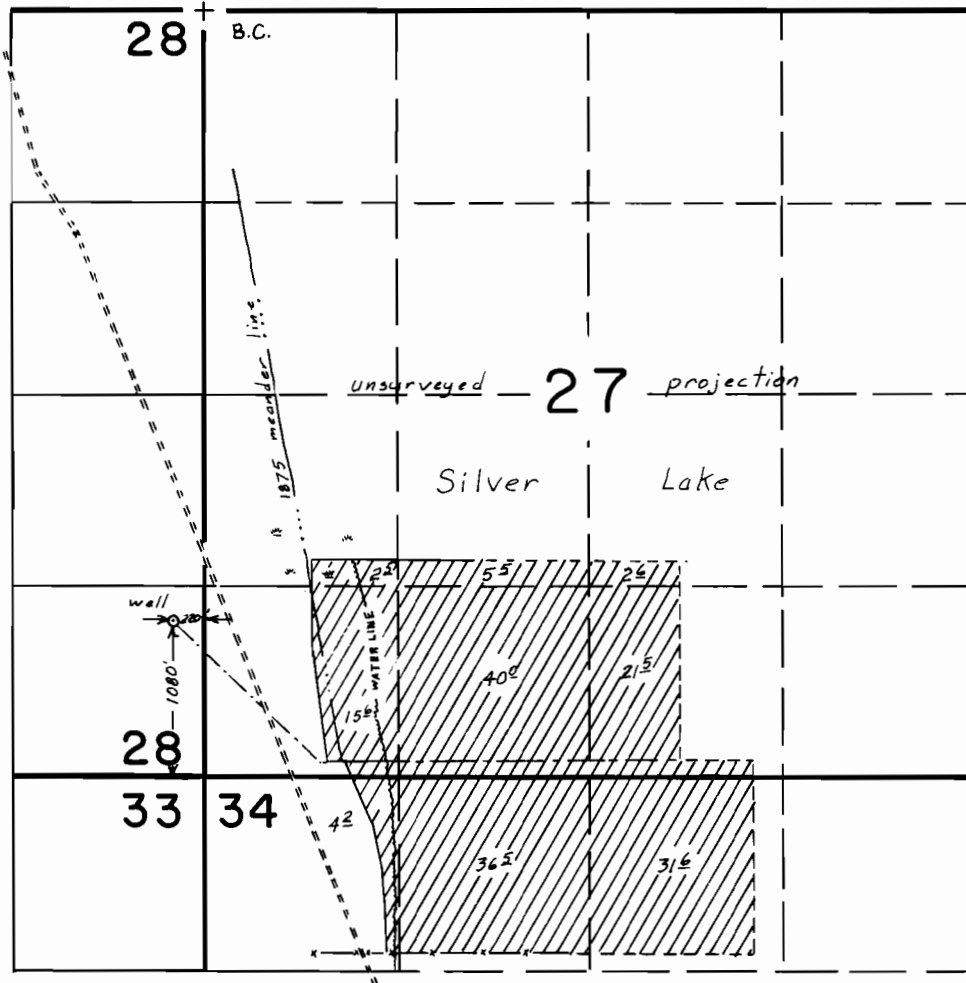

SCALE: 1" = 1320'

## FINAL PROOF SURVEY UNDER

Application No. G-10123.. Permit No. G-9201.....  
IN NAME OF

.....JEREMIAH O'LEARY.....

Surveyed MAY..7..... 1986., by LESLIE..OLSON...