


T.36S.,R.14E.,W.M.

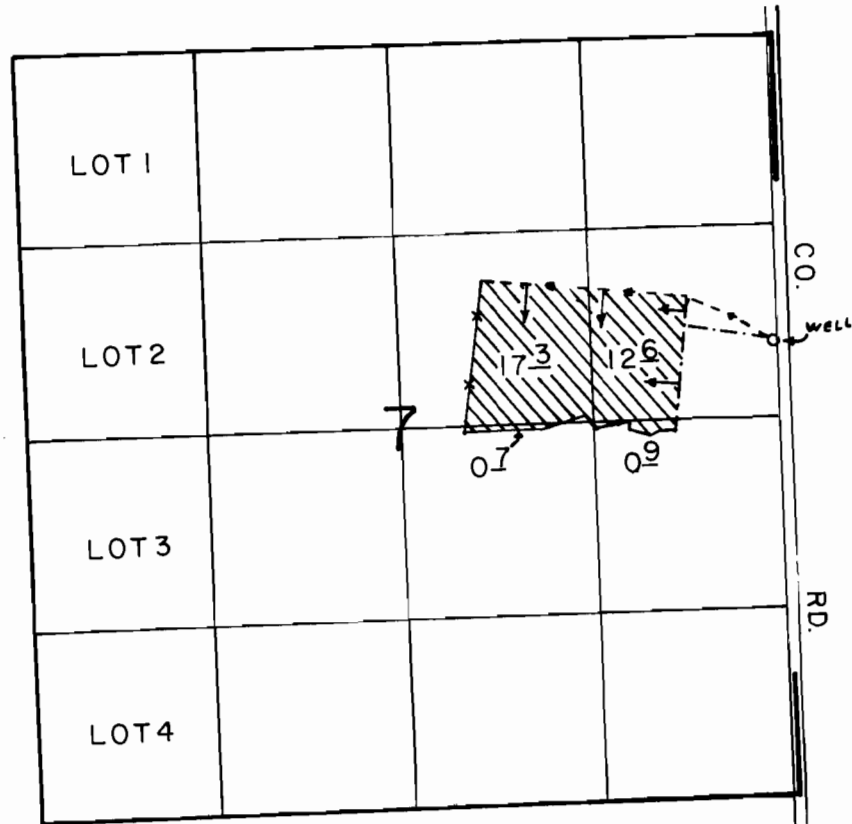

WELL LOC.: 2100' S. 850' W. FROM NE COR. OF SEC 7.
2075 100

SCALE: 1" = 1320'

FINAL PROOF SURVEY
UNDER

Application No. G-10174 Permit No. G-9207...
IN NAME OF

..... SIMONSEN FAMILY TRUST

Surveyed AUG. 13. 19. 91., by B.W. BISHOP.....

P.T.S 11-8-91 10/31/06 LHM RMS