



Well Location Map
 F.H. Nestlen Property
 in.
 Sec. 31 T2s R1e W.M.
 NE 1/4, SE 1/4, SE 1/4.,

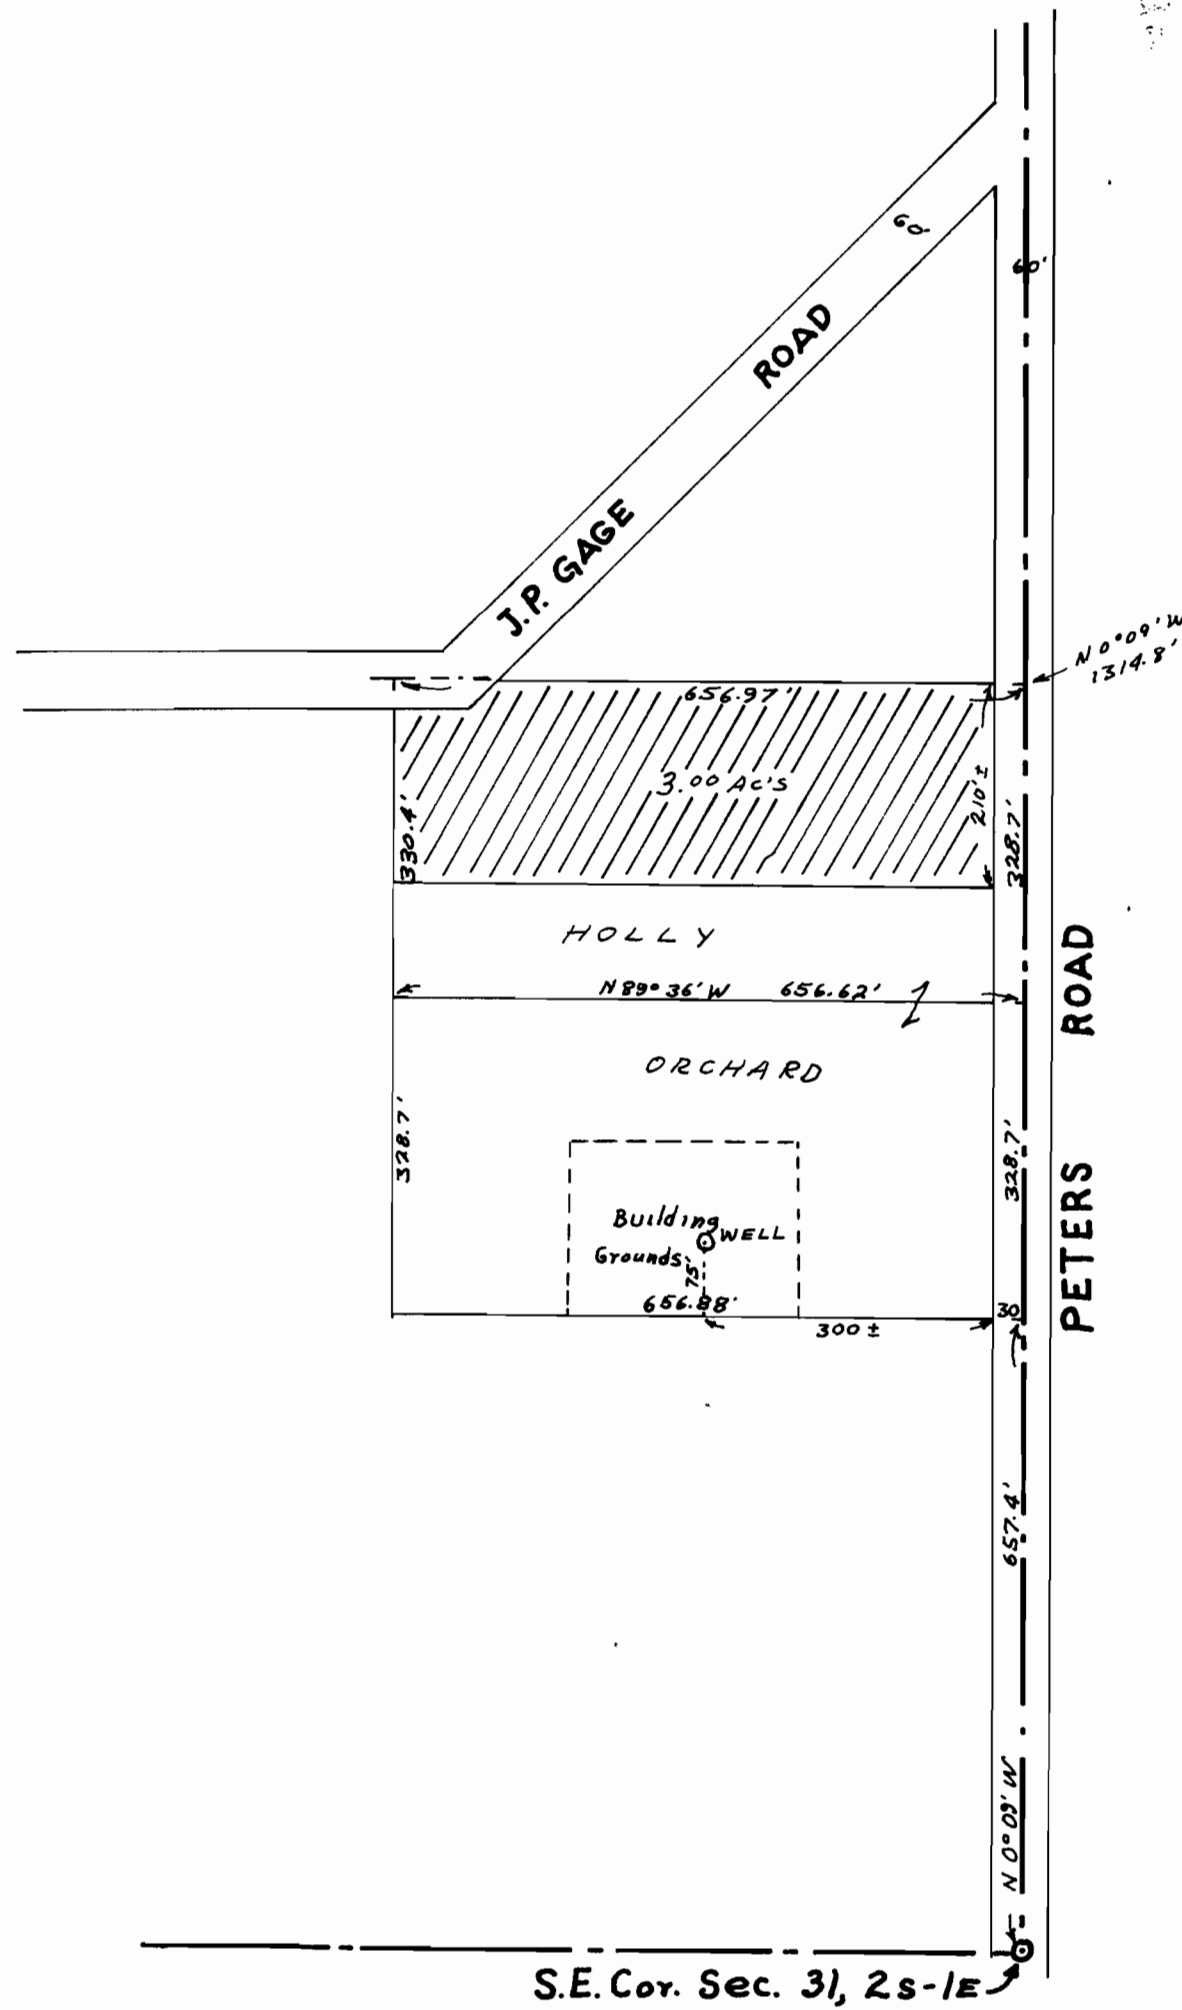

The well is $N0^{\circ}09'W$ 657.4' and $N89^{\circ}36'W$ 330',
 and North 75' From the S.E. Cor. of Section 31,
 T2S, R1E, W.M.
 Will irrigate about 3.00 Ac's

9.92 Ac's Total
 - 6.92 Holly + Bldgs
 3.00 Net to irr.

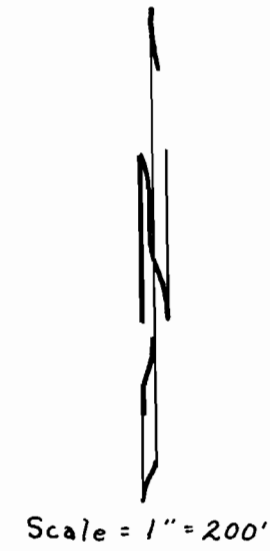

6/27/58 *ND*