Application No. G 9577

Permit No. G 9254

RECEIVED
JAN 27 1981
WATER RESOURCES DEPT
SALEM, OREGON

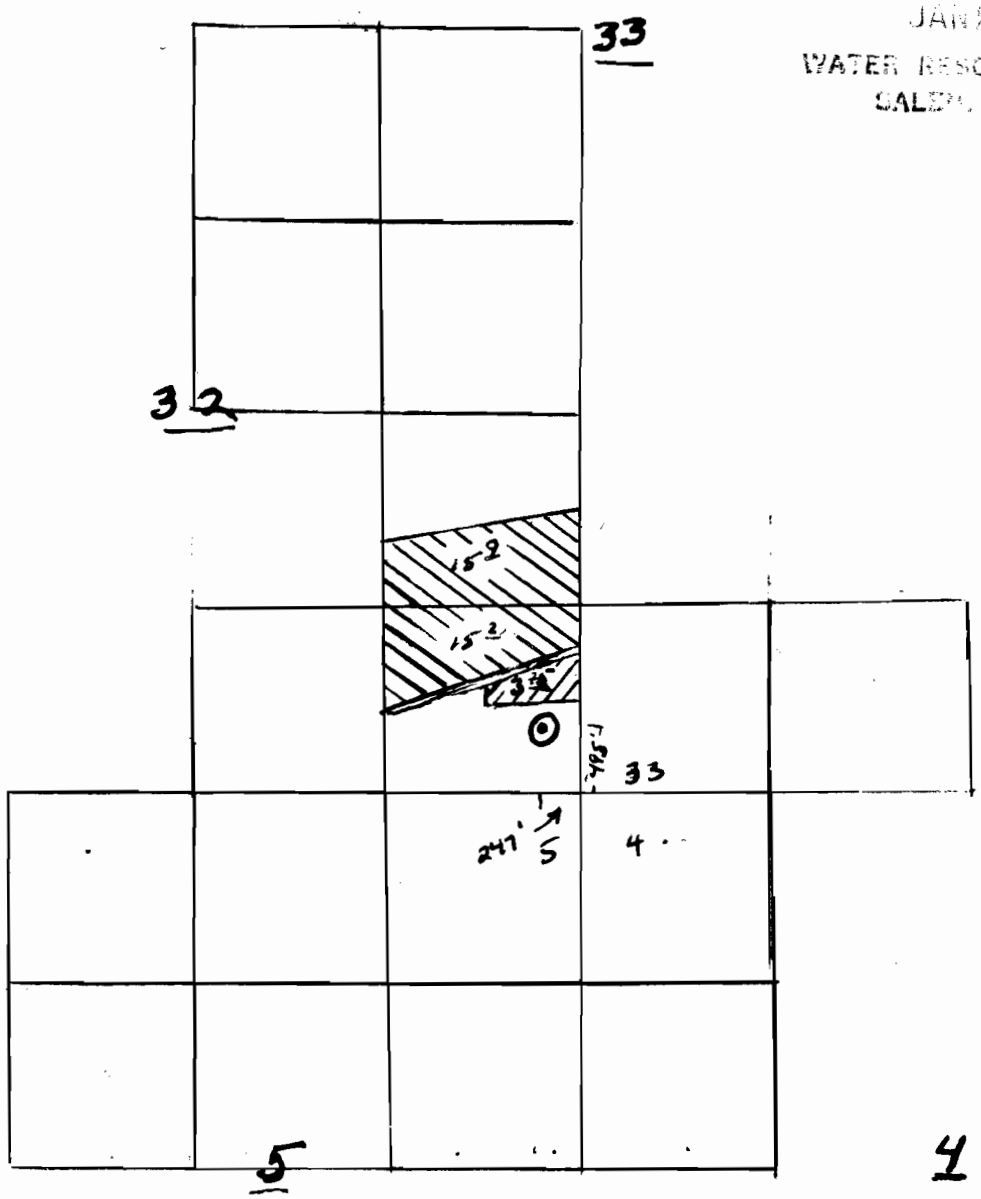


Scale 1" = 1/4 mile

Priority (Primary)

Well

Supplementary

R-58562
58513