


SURVEY No.
1539B

WATER RIGHT MAP
FOR
O. G. SALTER

NW cor Sec 1

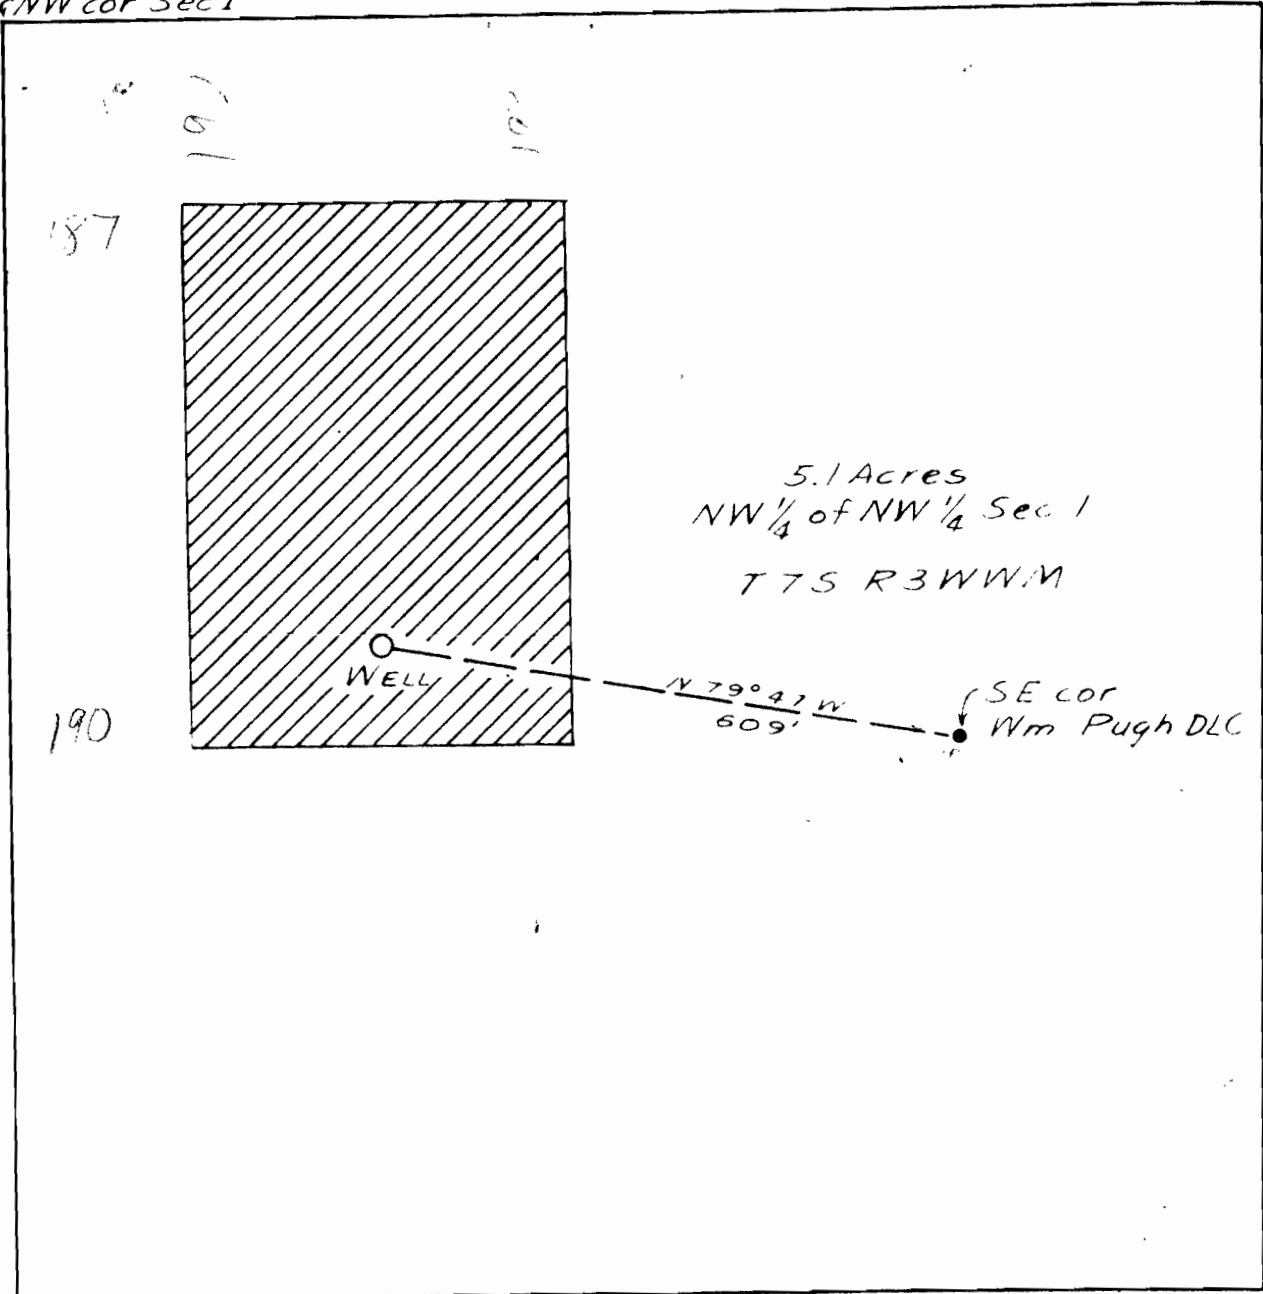

SCALE ~ 1" = 200'

David F Bates

Application No. G-1044
Permit No. G-928

DAVID F BATES
1810 Birchwood Dr
Salem, Oregon