


Amended MAP File #G-9337

Application No. G-9337
Permit No. G 9300

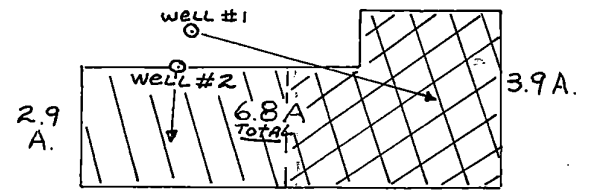

well #1 = 1040' N. & 910' W.
 well #2 = 970' N. & 940' W. Both from S.E. Cor., Sec. 3

T.17S. R.5W.
 1" = 400'

3 2
 10 11

RECEIVED RECEIVED

MAY 21 1981

APR 28 1981

WATER RESOURCES DEPT WATER RESOURCES DEPT
 SALEM, OREGON SALEM, OREGON