Application No. G-9609
Permit No. G 9335

SECTION 31 T.10S., R.4W. W.M.
BENTON COUNTY
1" = 400'
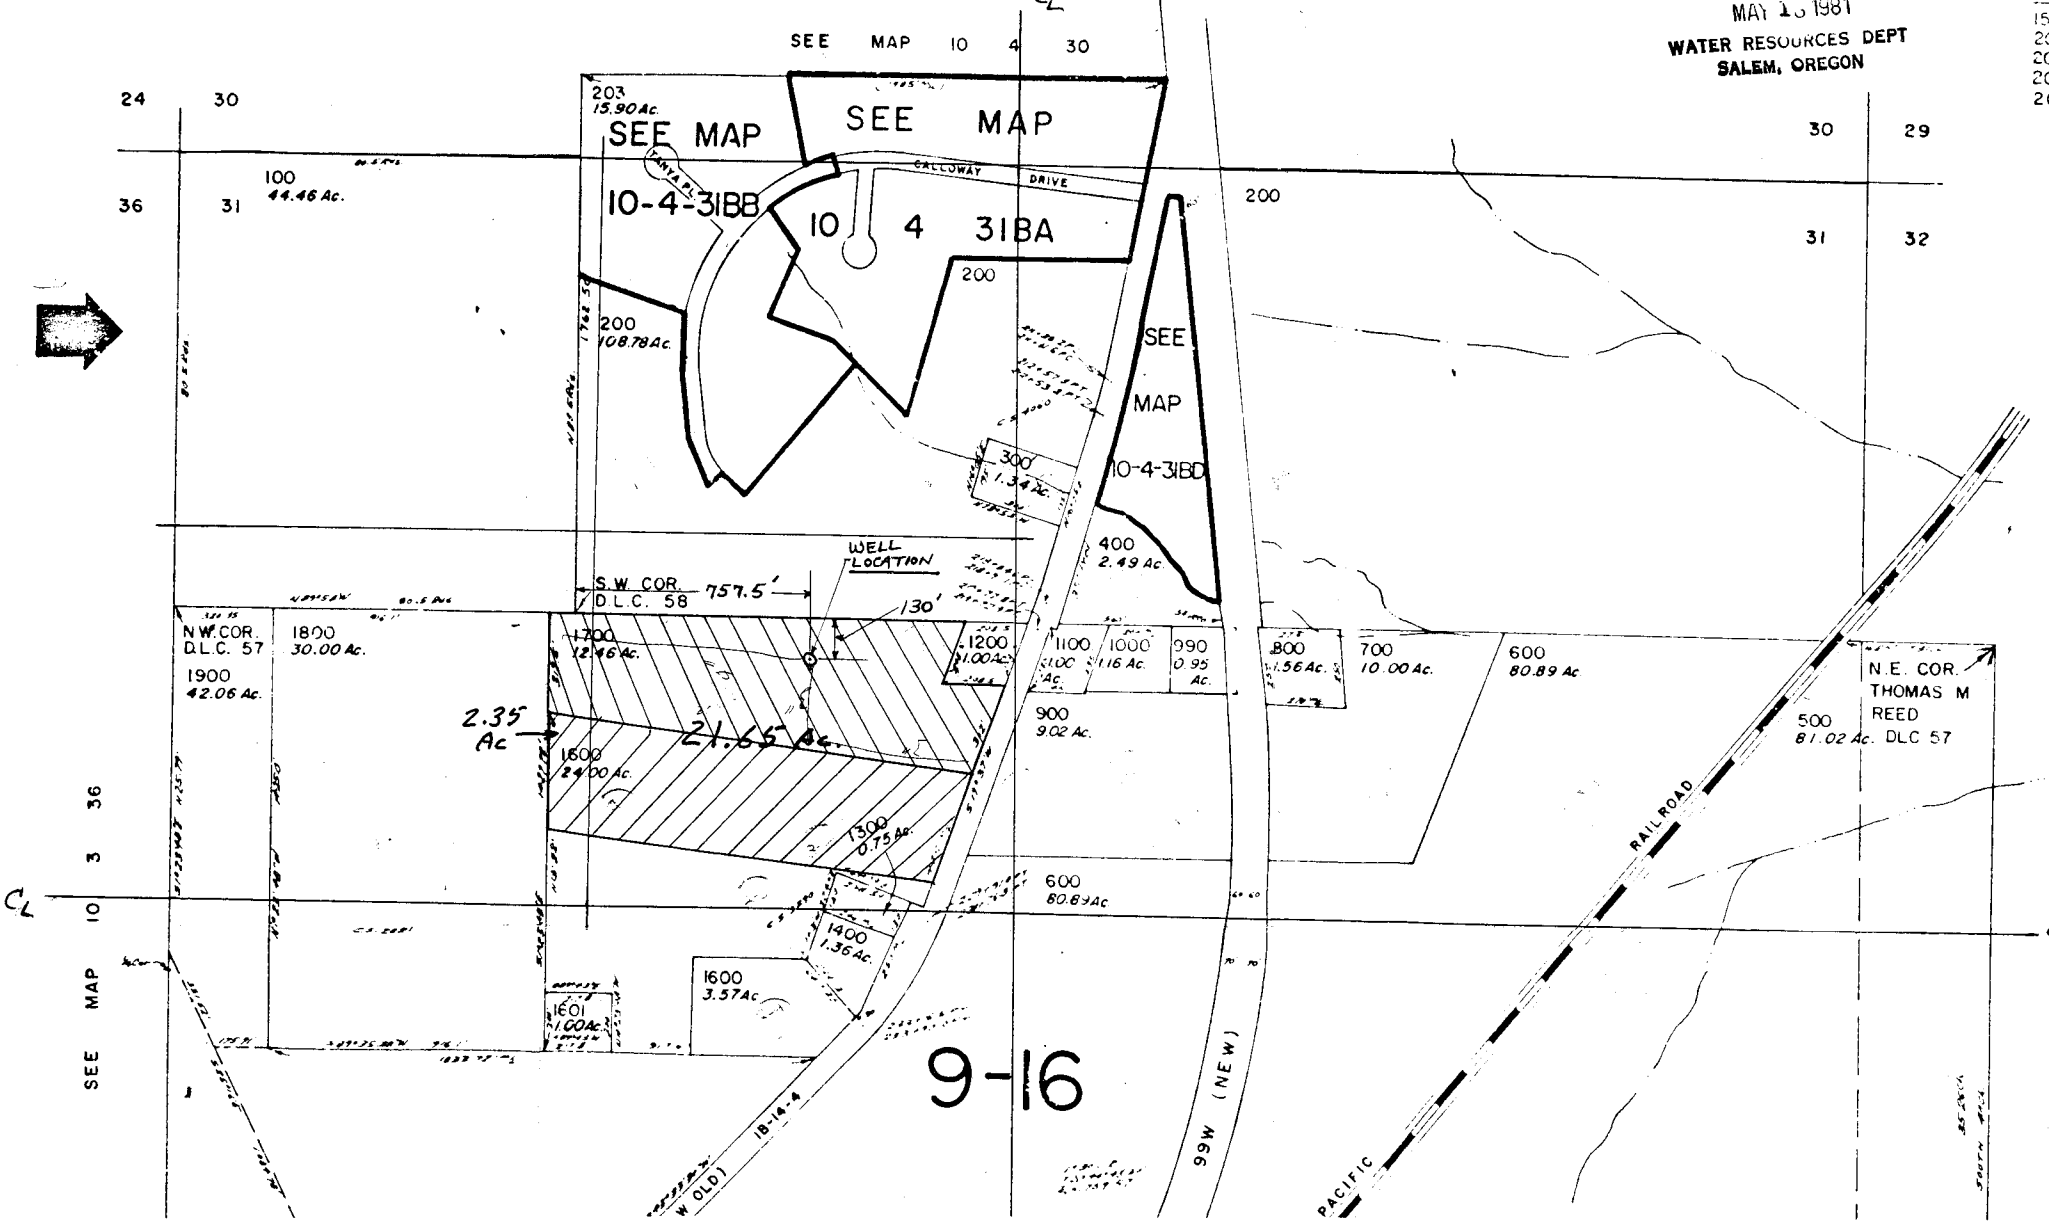
RECEIVED
MAY 15 1987
WATER RESOURCES DEPT
SALEM, OREGON