


T. 39 S., R. 5 W., W.M.

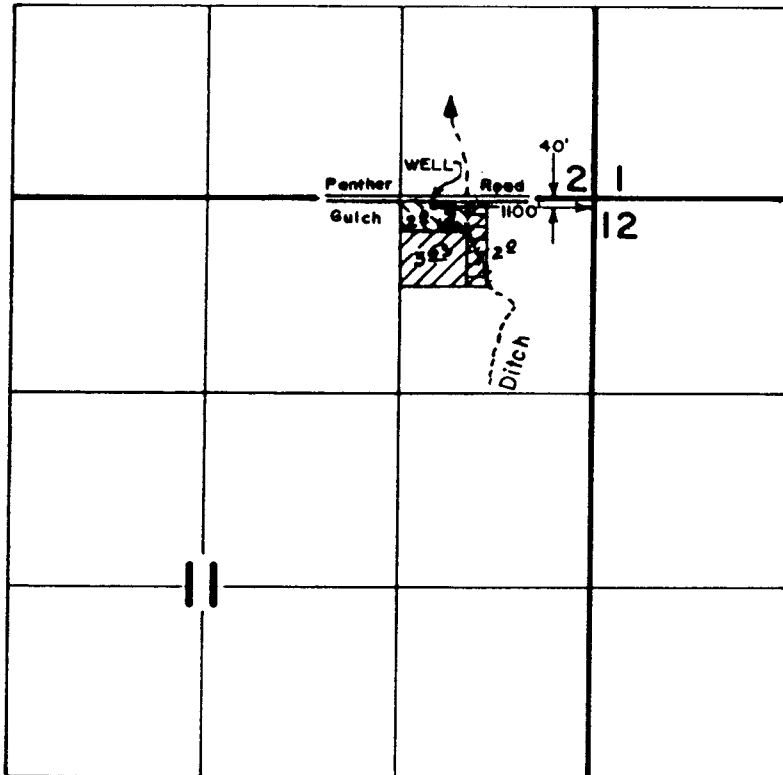

RECEIVED
SEP 11 1989




FINAL PROOF SURVEY
UNDER

TRANSFER NO. 4741
Application No. G-10270 Permit No. G-9362
IN NAME OF

FAYE M. RIGEL

Surveyed AUG. 11 1983, by B. S. JAMES

SCALE: 4" = 1 MILE

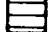-  PRIMARY
-  SUPPLEMENTAL
-  PRIMARY TR. NO. 4741

179-107R

TWB