
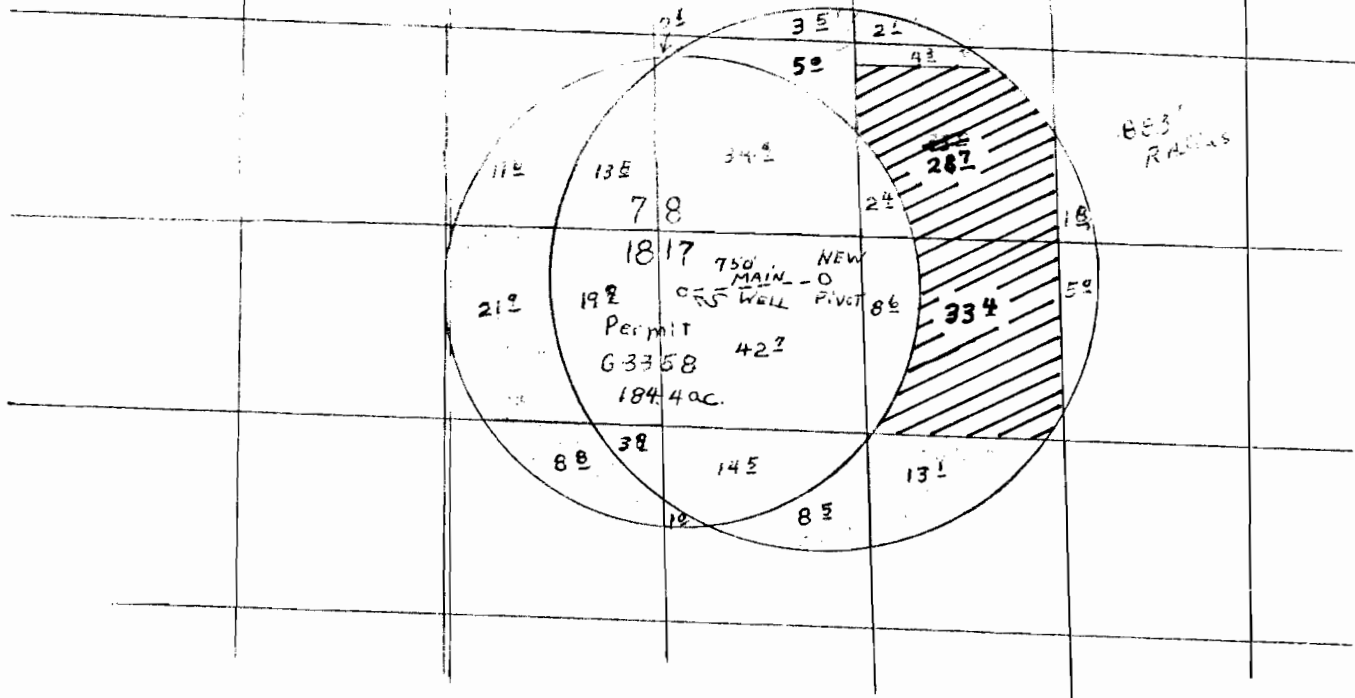


T24S R30E

RECEIVED
 WATER RESOURCES DEPT
 SALEM, OREGON

Well 300'E 3090'S From West 1/4 Cor Sec 8
 PIVOT 1050'

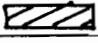

	ORIGINAL Permit	G-3358	140.2 + 43.4 = 183.6
	NEW APPLICATION	G-9522	330.621 ✓
	Transferred To		43.4 Ac.
	Transferred From		43.4 Ac.

Application No. G-9522
 Permit No. G 9382