


POINT OF DIVERSION TRANSFER APPLICATION FOR  
 AVION WATER COMPANY, INC.  
 LOCATED IN SECTION 28  
 TOWNSHIP 15 SOUTH, RANGE 12 EAST, WM  
 CROOK COUNTY, OREGON  
 AUGUST 8, 2003

To

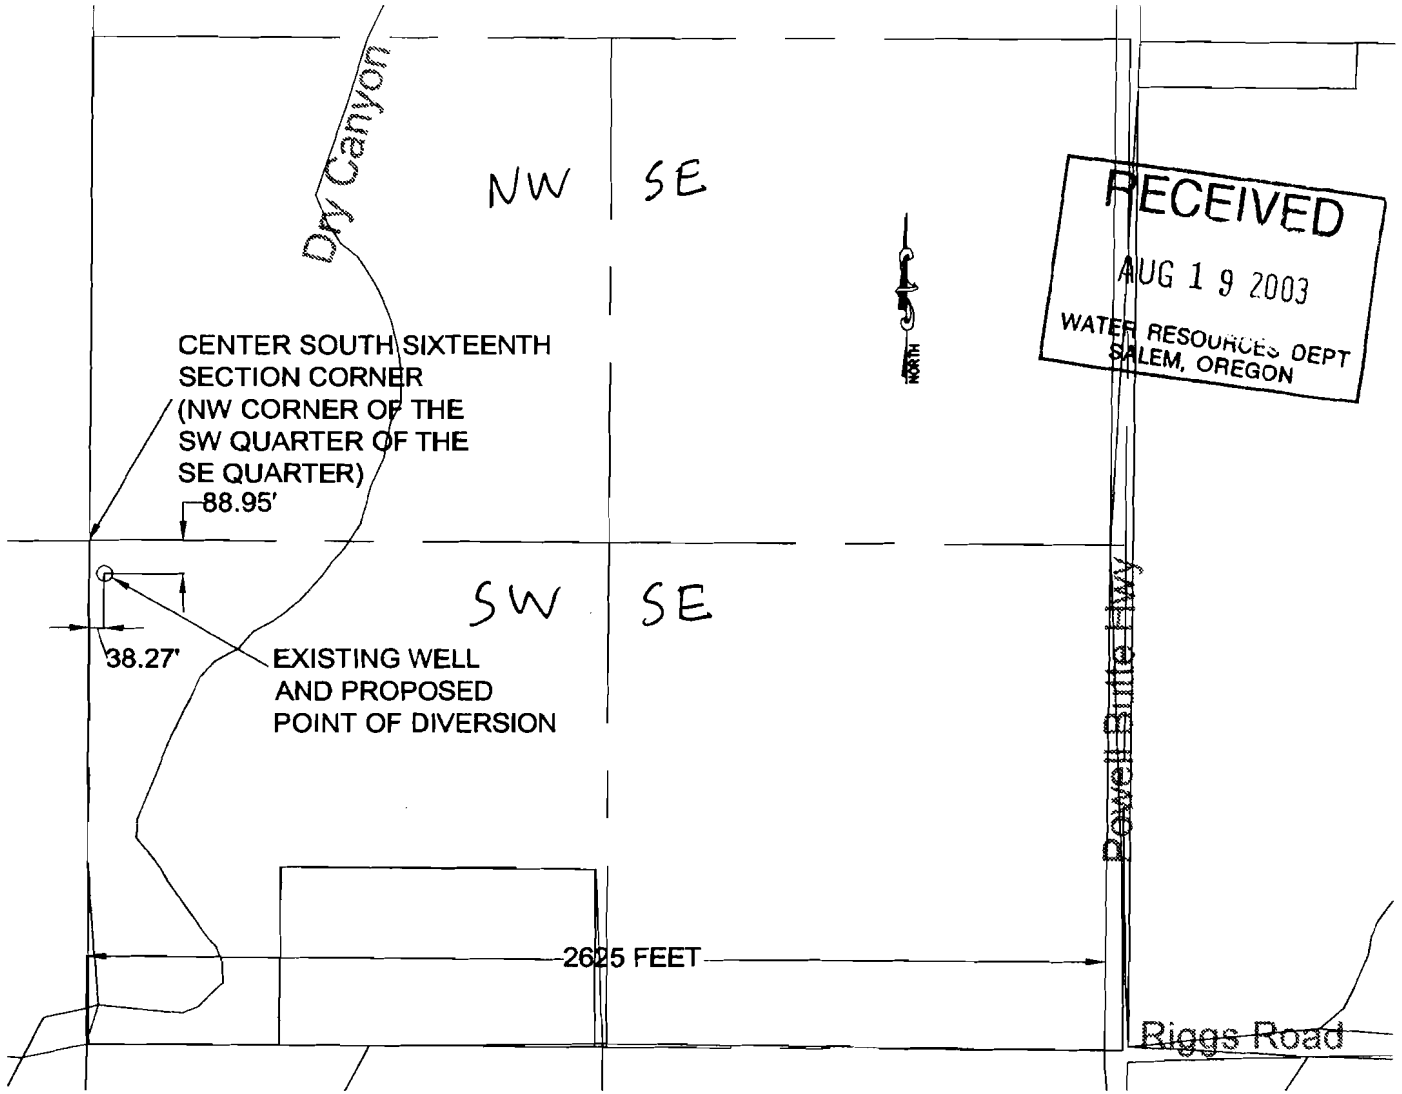

**Certified Water Right Examiner**  
 #137  
*Thomas A. Walker*  
**Thomas A. Walker**  
 Nov. 19, 1987  
**STATE OF OREGON**  
 EXPIRES 6-30-04

NOTE: THIS MAP WAS PREPARED TO IDENTIFY THE LOCATION OF WATER RIGHTS. THIS MAP IS NOT INTENDED TO PROVIDE DIMENSIONS OR THE LOCATION OF PROPERTY OWNERSHIP LINES.

Office: BEND / System: WHP-BND-KWS701 / User: CSCHNEIDER

DESIGNED BY:	CHECKED BY:				
DRAWN BY:	APPROVED BY:				
LAST EDIT:	PLOT DATE: 08/08/03				
DATE	BY	REV	REVISION	CK'D	APPR.

**WH**  
**FACILTY**

920 Donkey, Suite C-100  
 Bend, Oregon  
 97702-1041

(541) 388-4366  
 (541) 388-4389 Fax  
 wj@aol.com

AVION WATER COMPANY, INC

**POINT OF DIVERSION TRANSFER**

CROOK OREGON

SCALE: 1"=500'	PROJECT NO.	DRAWING FILE NAME:	SHEET
-------------------	-------------	--------------------	-------

T-9525