


NORTH

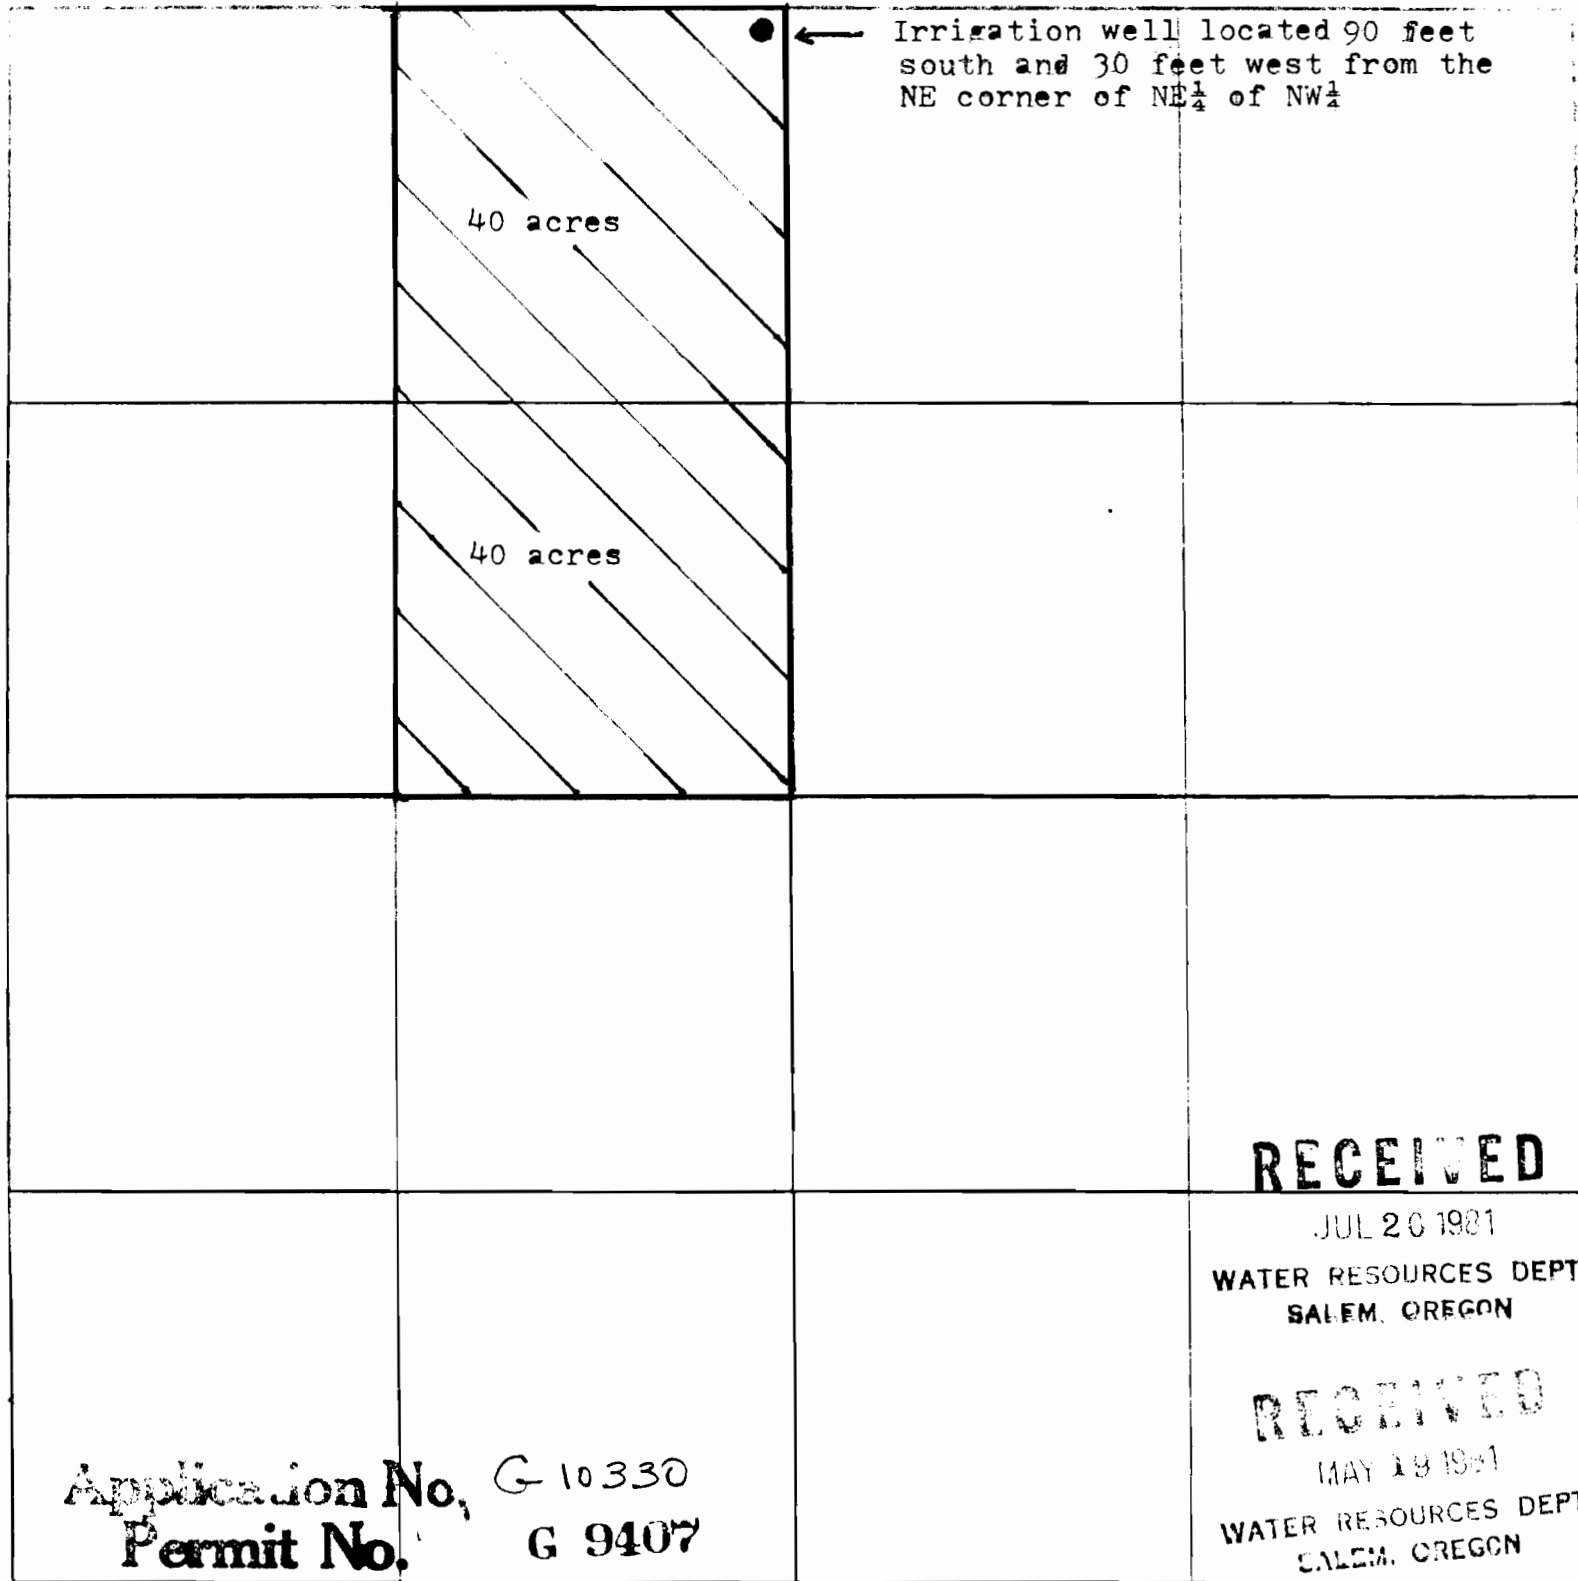

S

Remarks scale - 8" = 1 mile - 660'.

NOTES: Main pipeline along east edge of field;  
80 acres to be irrigated by wheelline.