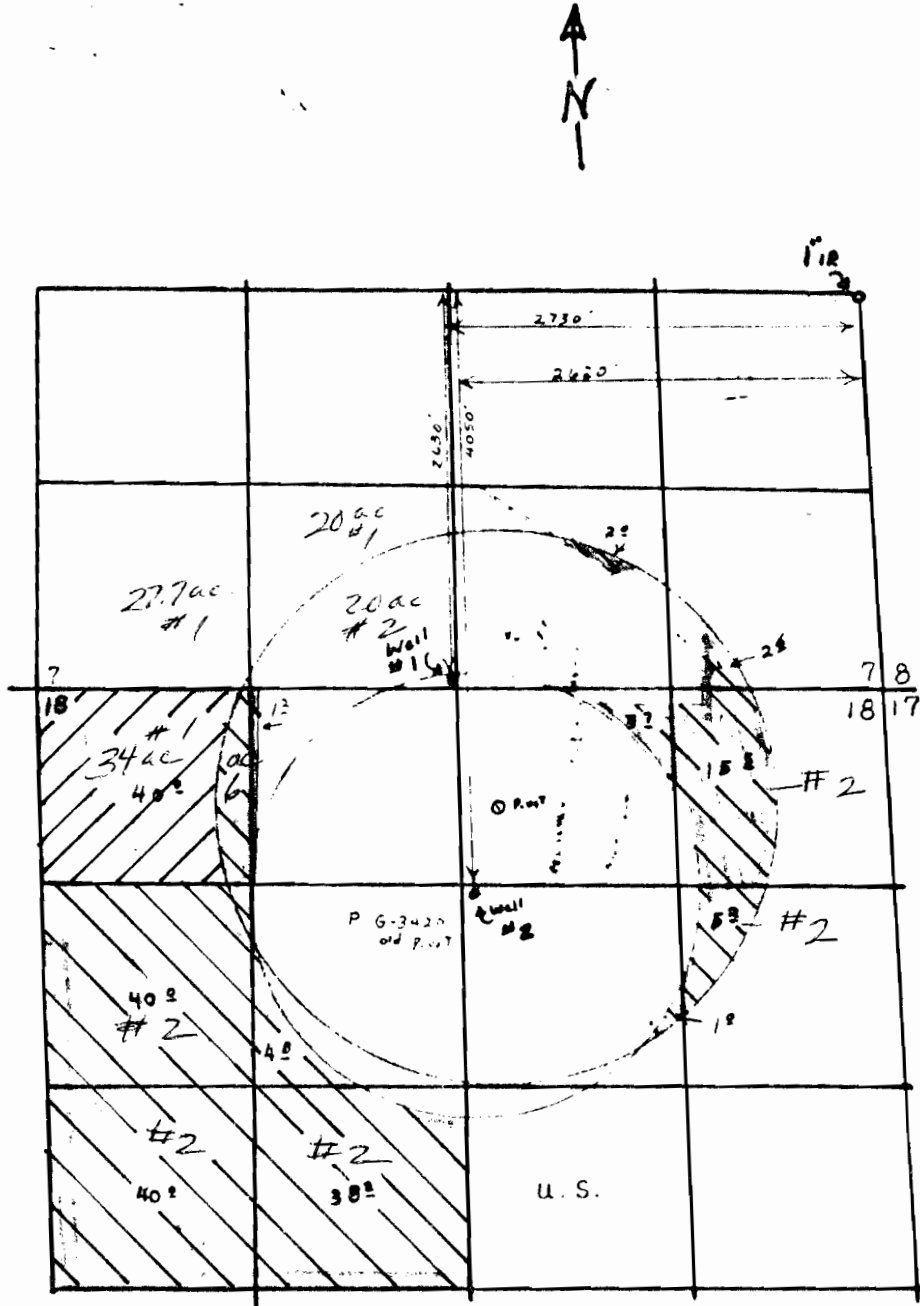


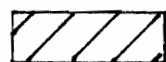
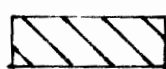
Application No. G 9858 T 24S R 30E  
Permit No. G 9460

RECEIVED  
SEP 29 1981  
WATER RESOURCES DEPT  
SALEM, OREGON

RECEIVED

OCT 19 1981  
WATER RESOURCES DEPT  
SALEM, OREGON



 well #1  
 well #2

RECEIVED  
JUL 31 1980  
WATER RESOURCES DEPT  
SALEM, OREGON