


TSS, R/W W.M.

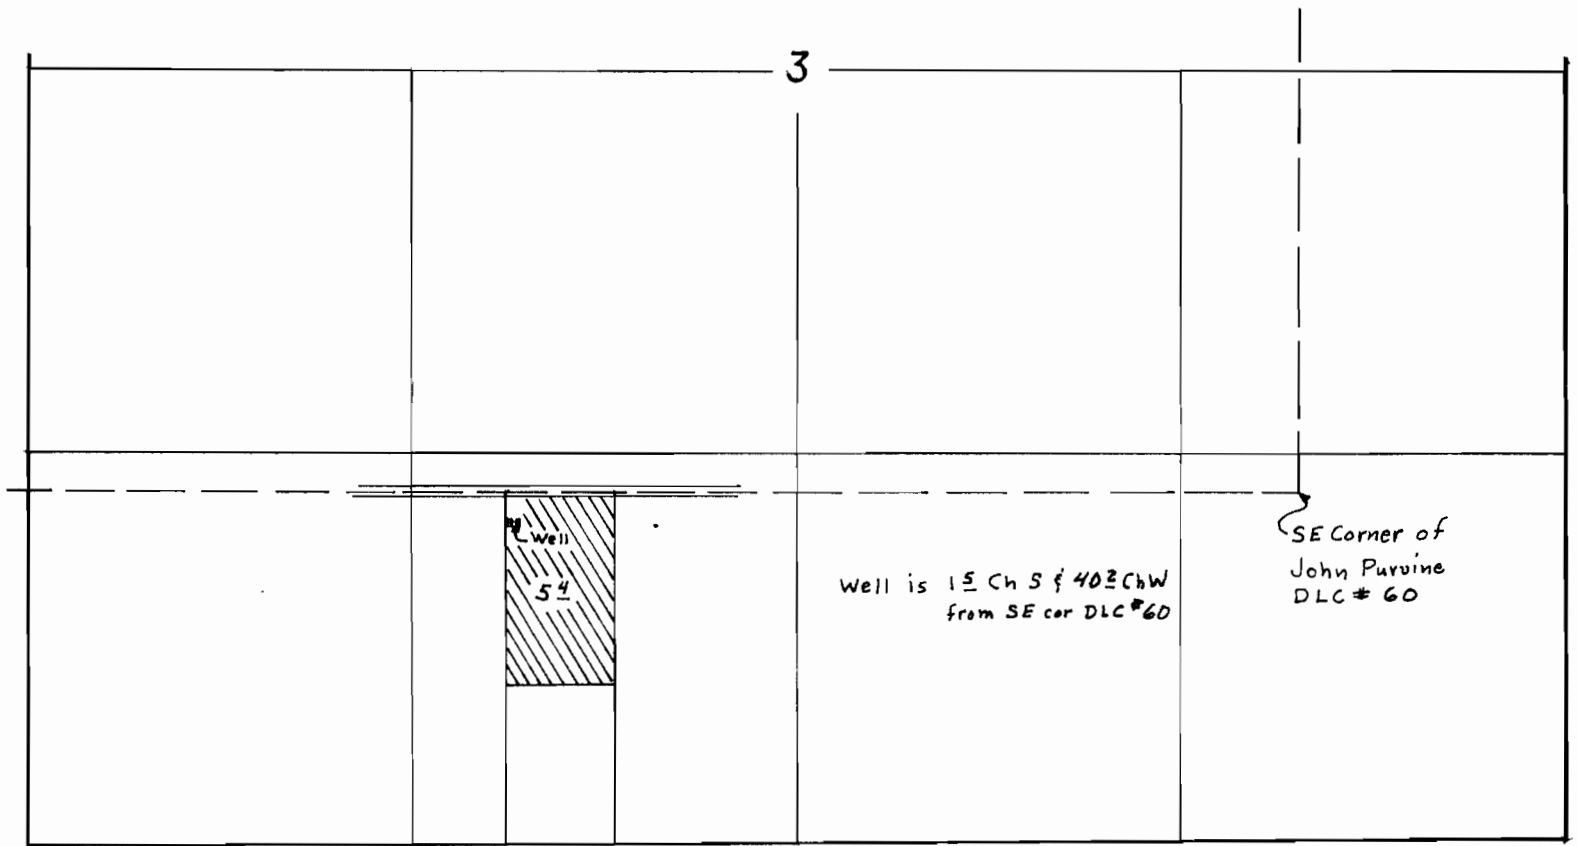

Application No. G-1094
Permit No. G-947