


Application No. *H* 9979  
Permit No. G 9514

T. 31  $\dot{\bar{E}}$  32S R 3W W.M.

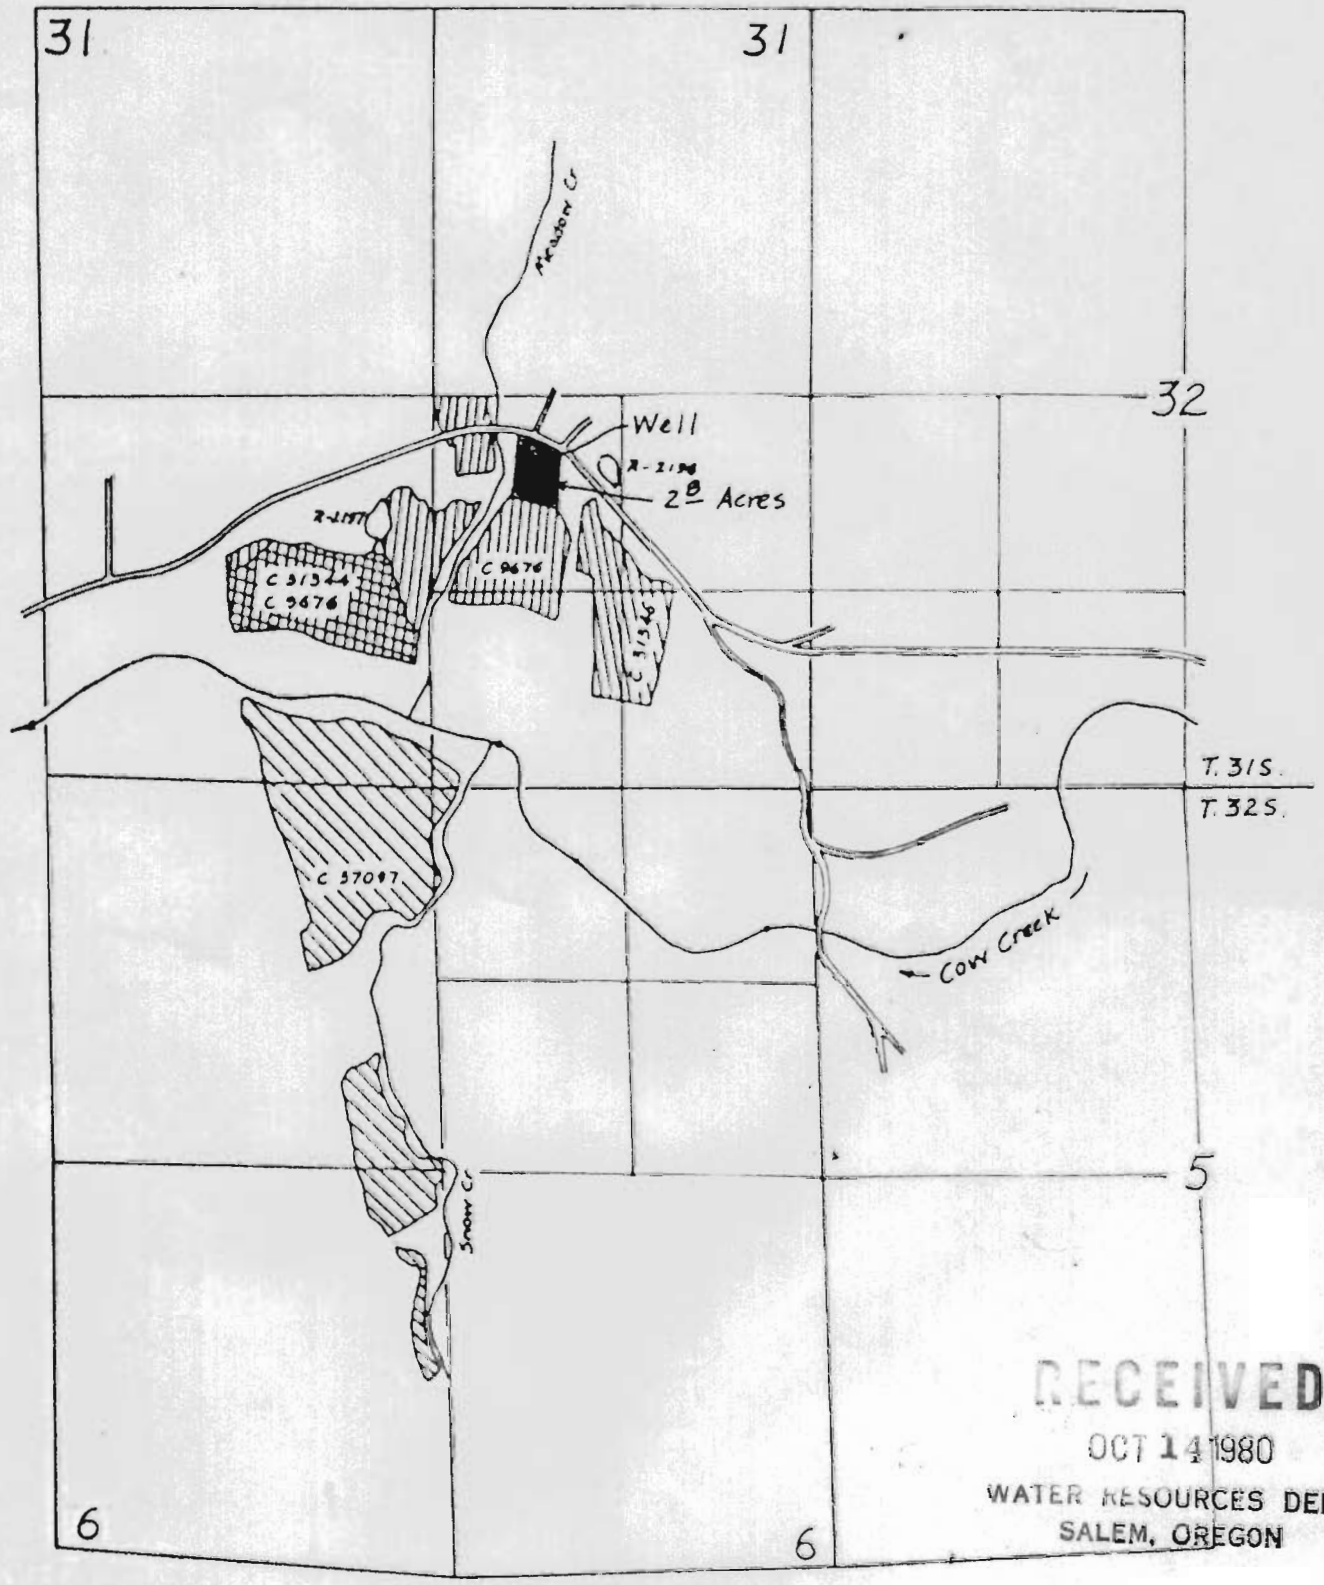

Scale: 4" = 1 mile

Well is 2220' N. and 1900' W. from SE cor. Sec. 31.