PACIFIC COAST NURSERY
WATER RIGHTS MAP

12/81

RECEIVED
JAN 20 1982
WATER RESOURCES DEPT.
SALEM, OREGON

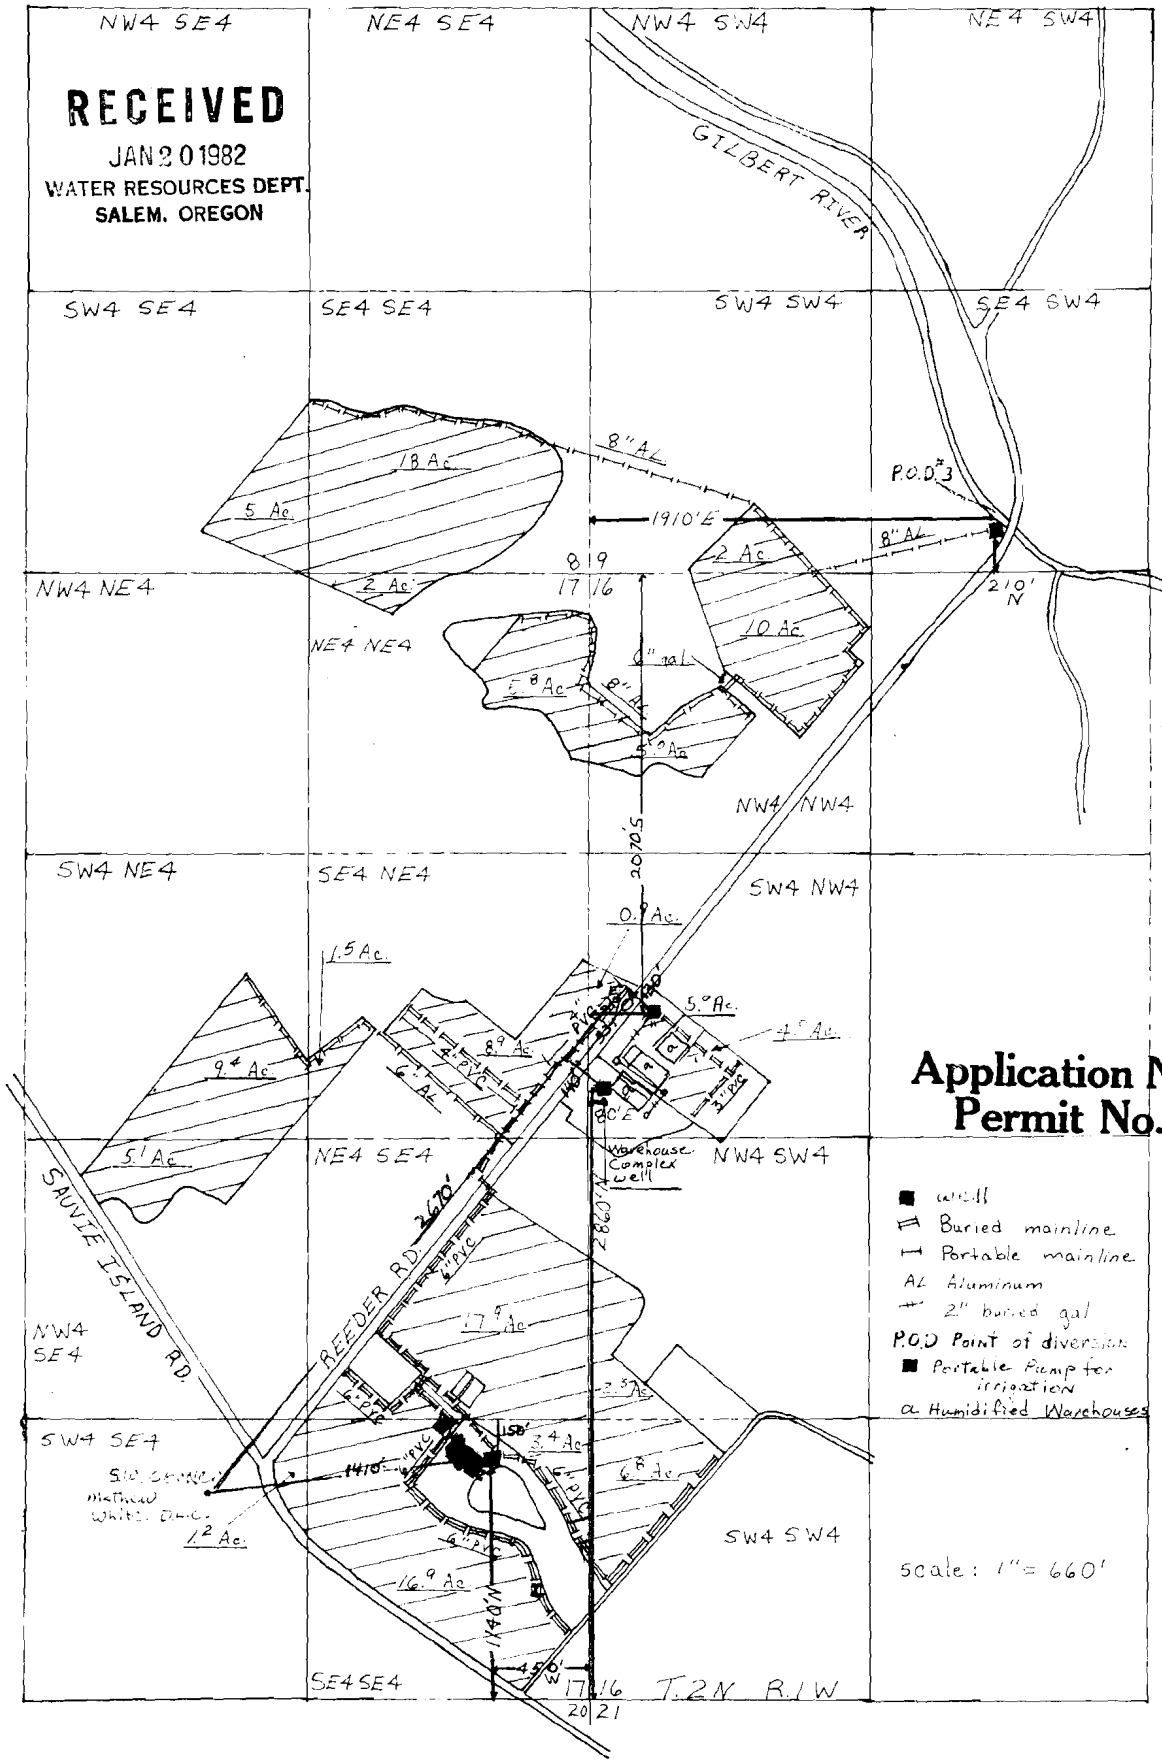

Application No. G-9744
Permit No. G 9540

- ■ well
- Buried mainline
- Portable mainline
- AL Aluminum
- 2" buried gal
- P.O.D Point of diversion
- ■ Portable Pump for irrigation
- a Humidified Warehouses

scale: 1" = 660'

U. S. DEPARTMENT OF AGRICULTURE
SOIL CONSERVATION SERVICE

APPROVED BY (Marked in Yellow)
DRAWING NO. Hot house Well and Property and Warehouse Complex
SHEET
DESIGNED BY
CHECKED BY
DATE

Form SCS-313A (March 195)

U. S. GOVERNMENT PRINTING OFFICE