



Application No. G 9982
Permit No. G 9551

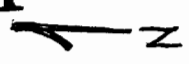

RECEIVED
JAN 29 1982
WATER RESOURCES DEPT
SALEM, OREGON

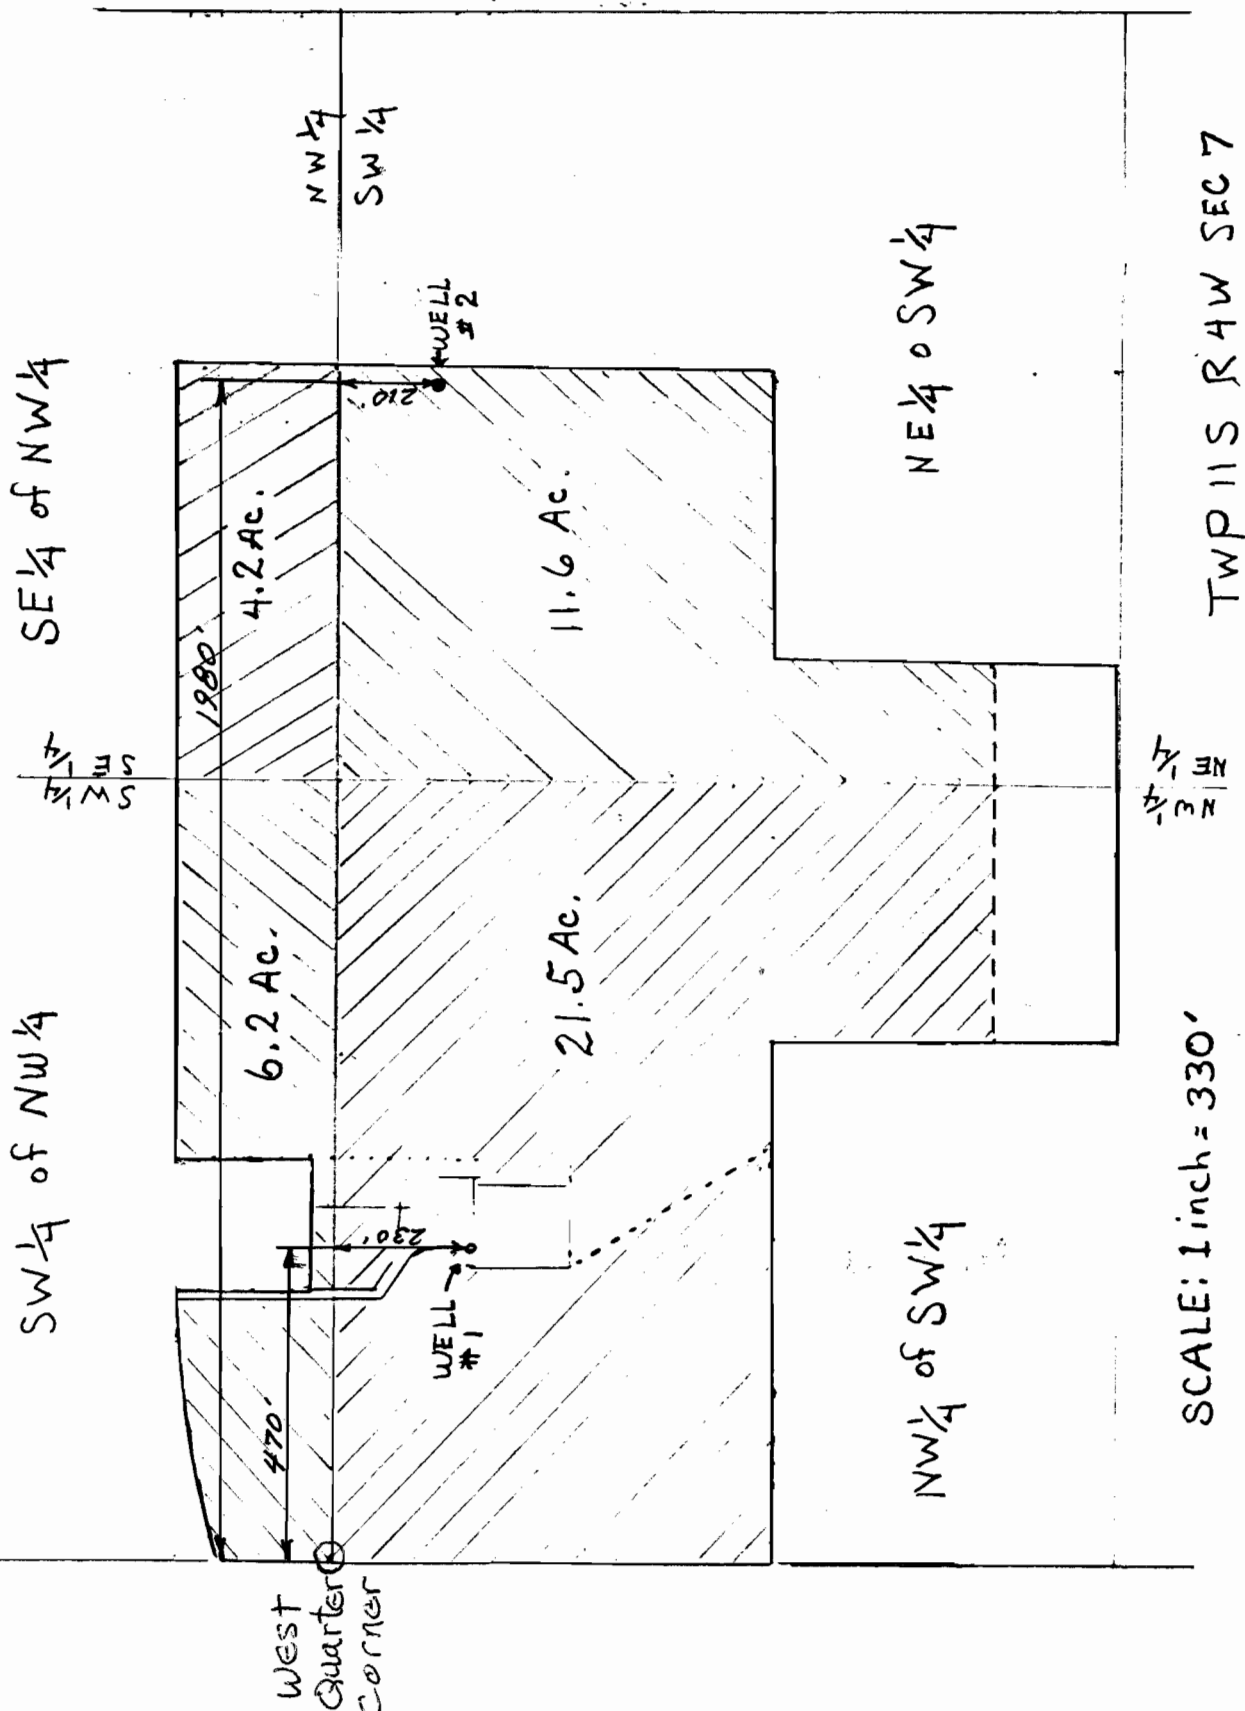

TWP 11 S R 4 W SEC 7

SCALE: 1 inch = 330'

RECEIVED
OCT 16 1980
WATER RESOURCES DEPT
SALEM, OREGON