


T. 38 S., R. 5 W., W. M.

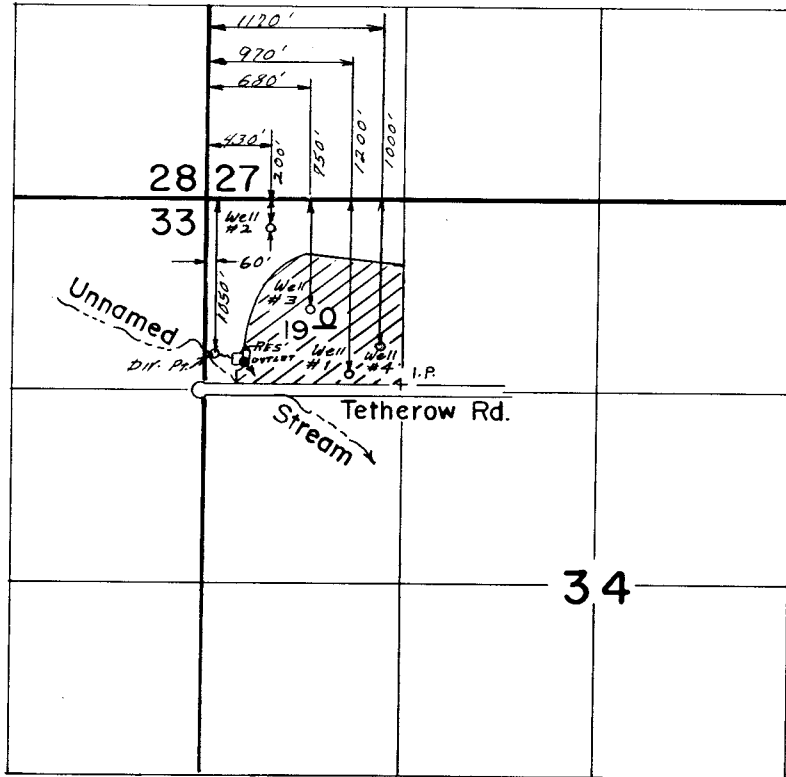

Scale: 1" = 1320'

**FINAL PROOF SURVEY**

UNDER

G-10341                      G-9572

R-58188                     R-7918

Application No. 58189      Permit No. 44364

IN NAME OF

RAYMOND & MARGARET PRAG

Surveyed AUG. 8. 1988, by B. S. JAMES