

SECTION PLAT

Section 8-9

Township 27S


Range 34E

County of HARNEY

State of OREGON

NORTH

89

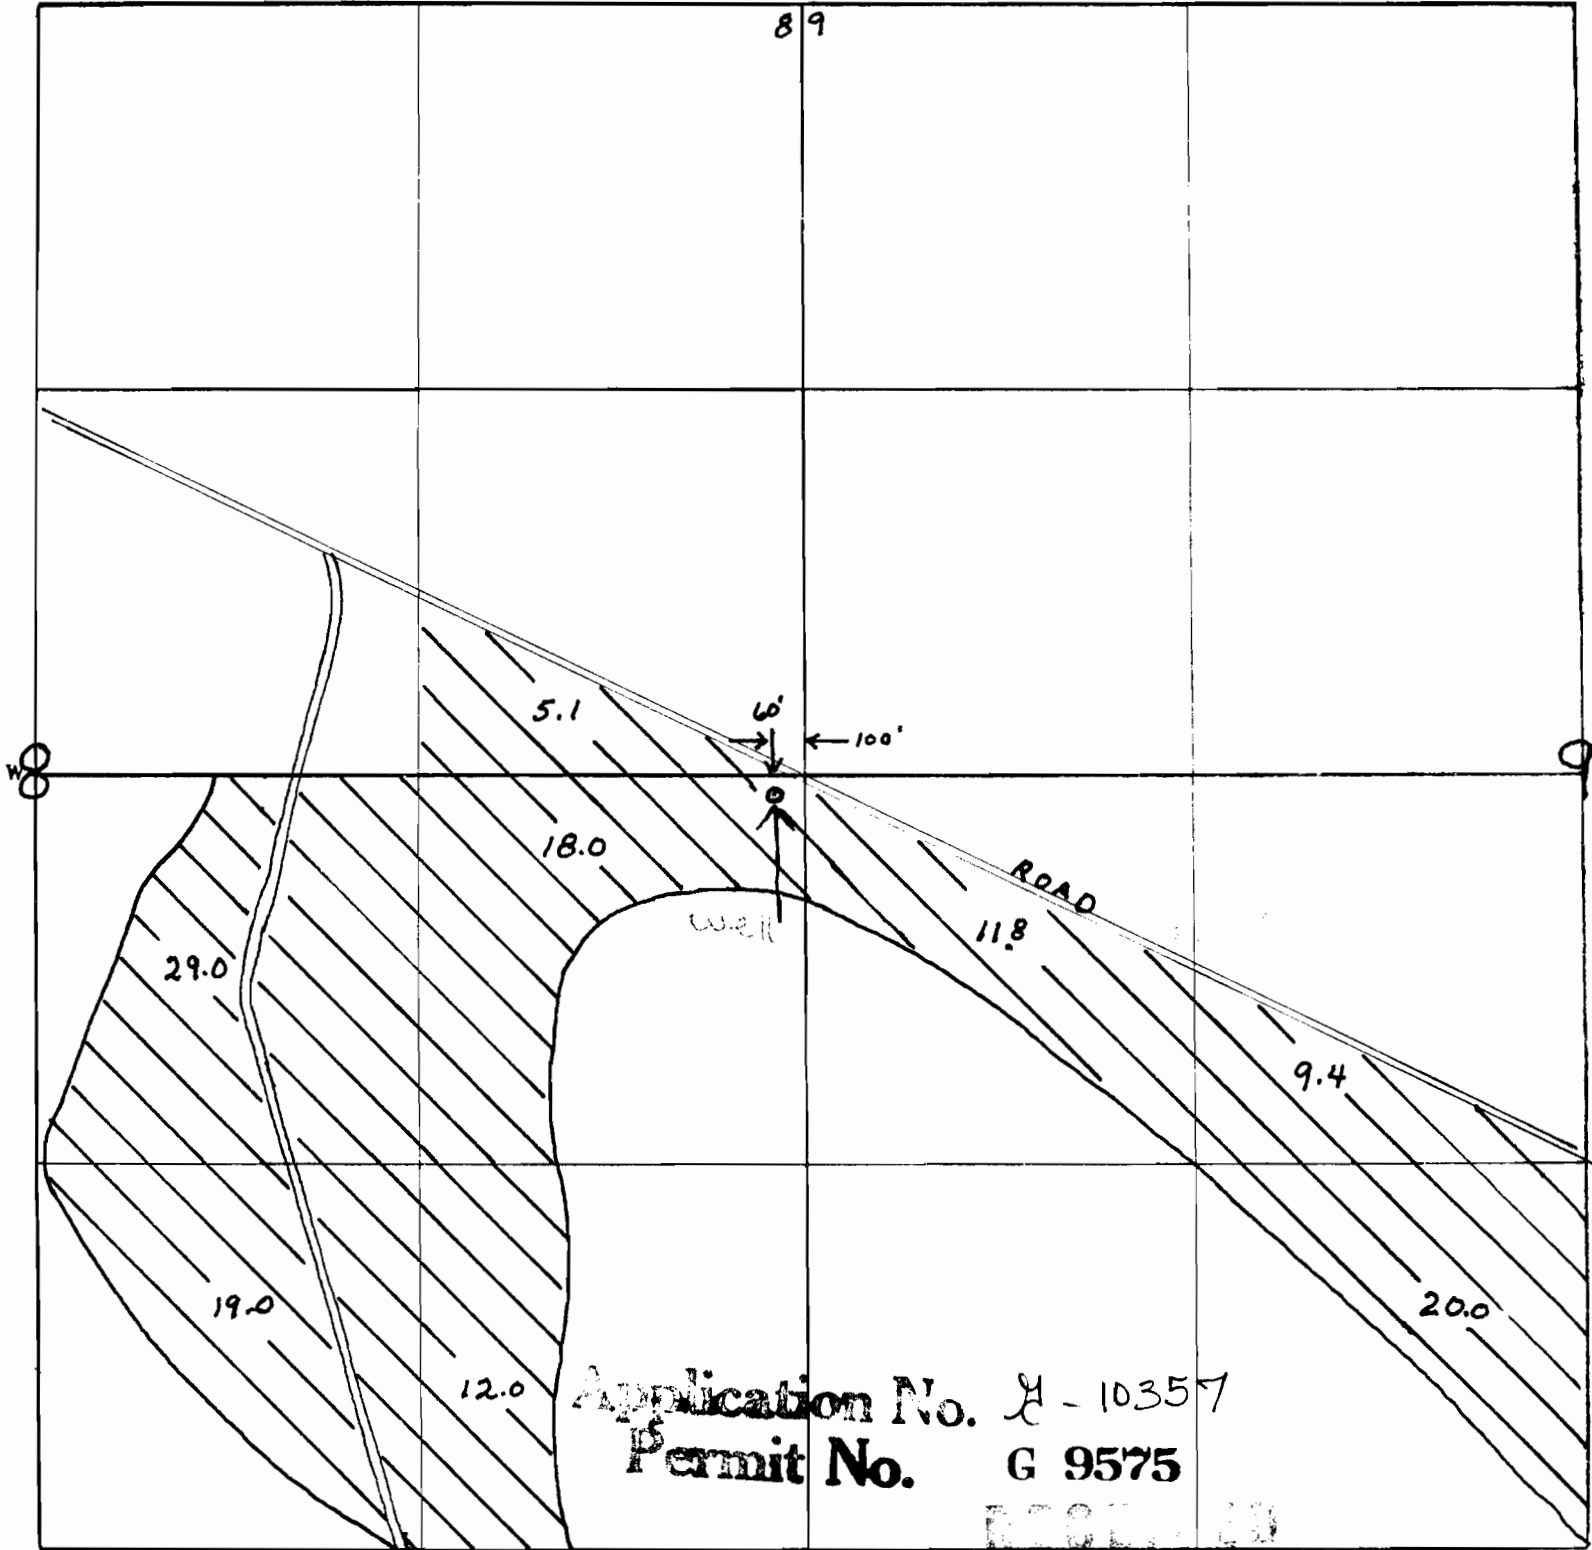

Application No. A-10357
Permit No. G 9575

RECORDED

UN 3171

Remarks scale - 8" = 1 mile - 660' -

WATER RESOURCES DEPT
SALEM OREGON