


RECEIVED  
MAR 5 1982  
WATER RESOURCES DEPT  
SALEM, OREGON

REX E POTTER & LILLY C POTTER  
SECTION 32, T22S, R7W, WM  
DOUGLAS CO  
SCALE 1" = 400'

Application No. G-10391  
Permit No. G 9597

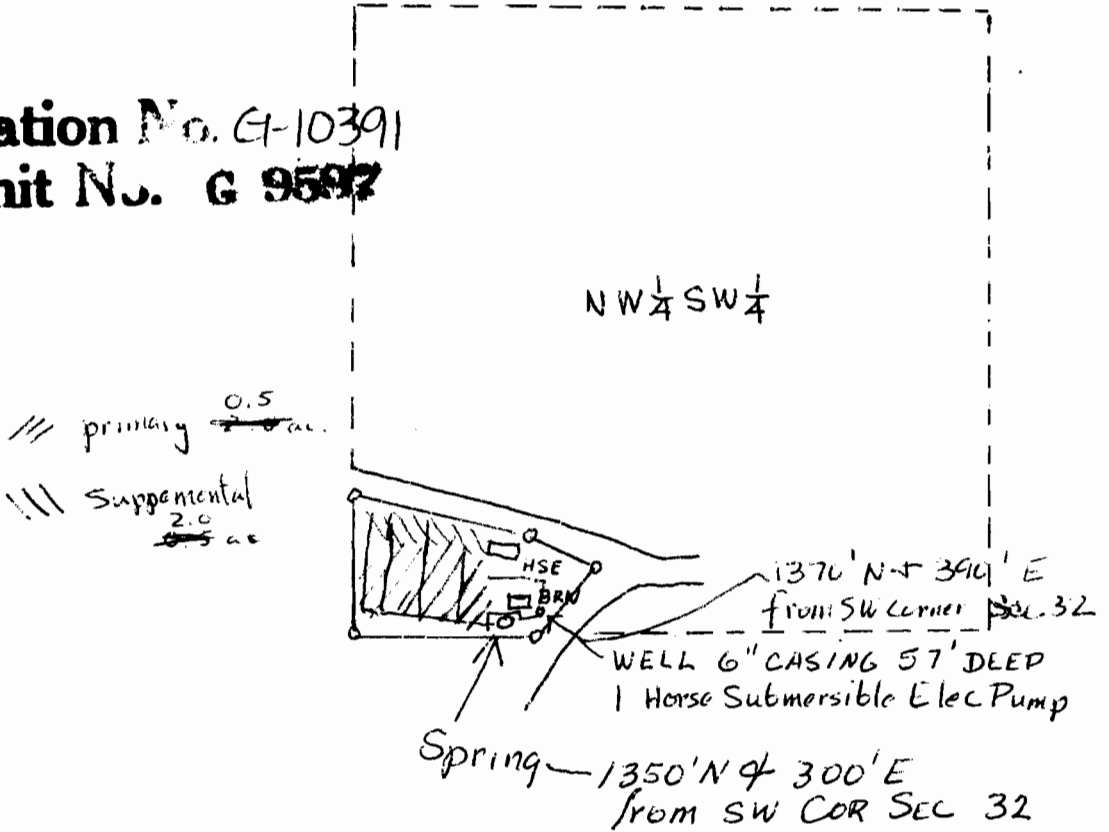

RECEIVED  
JUN 22 1981  
WATER RESOURCES DEPT  
SALEM, OREGON

