


# T. 28 S., R. 15 E., W.M.

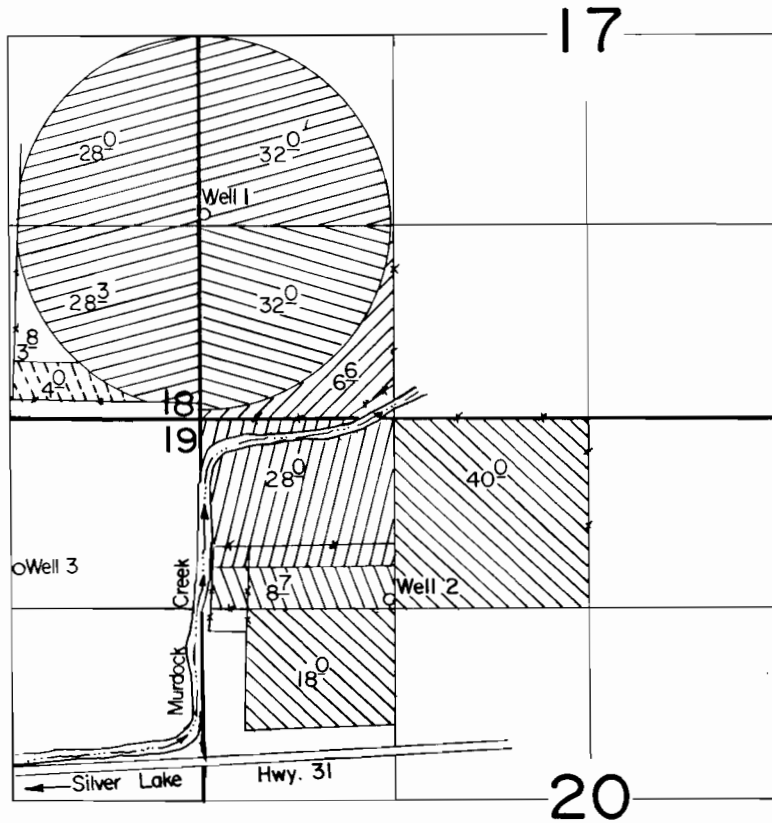

Well 1 Loc.: 1400' N. & 20' E.  
 Well 2 Loc.: 1250' S. & 1290' E.  
 Well 3 Loc.: 1040' S. & 1250' W. ; all from NW Cor. Sec. 20.

Scale: 1" = 1320'

## FINAL PROOF SURVEY

UNDER

|                         |                    |         |       |
|-------------------------|--------------------|---------|-------|
|                         |                    | Primary | Supp. |
|                         | T- 4868            |         |       |
|                         | T- 4869            |         |       |
| G-10411                 | G- 9599            |         |       |
| G-10384                 | G- 9463            |         |       |
| Application No. G-11196 | Permit No. G-10330 |         |       |

IN NAME OF

# LAWRENCE & MARJORIE IVERSON

Surveyed Sept. 16, 1985, by T. Warren