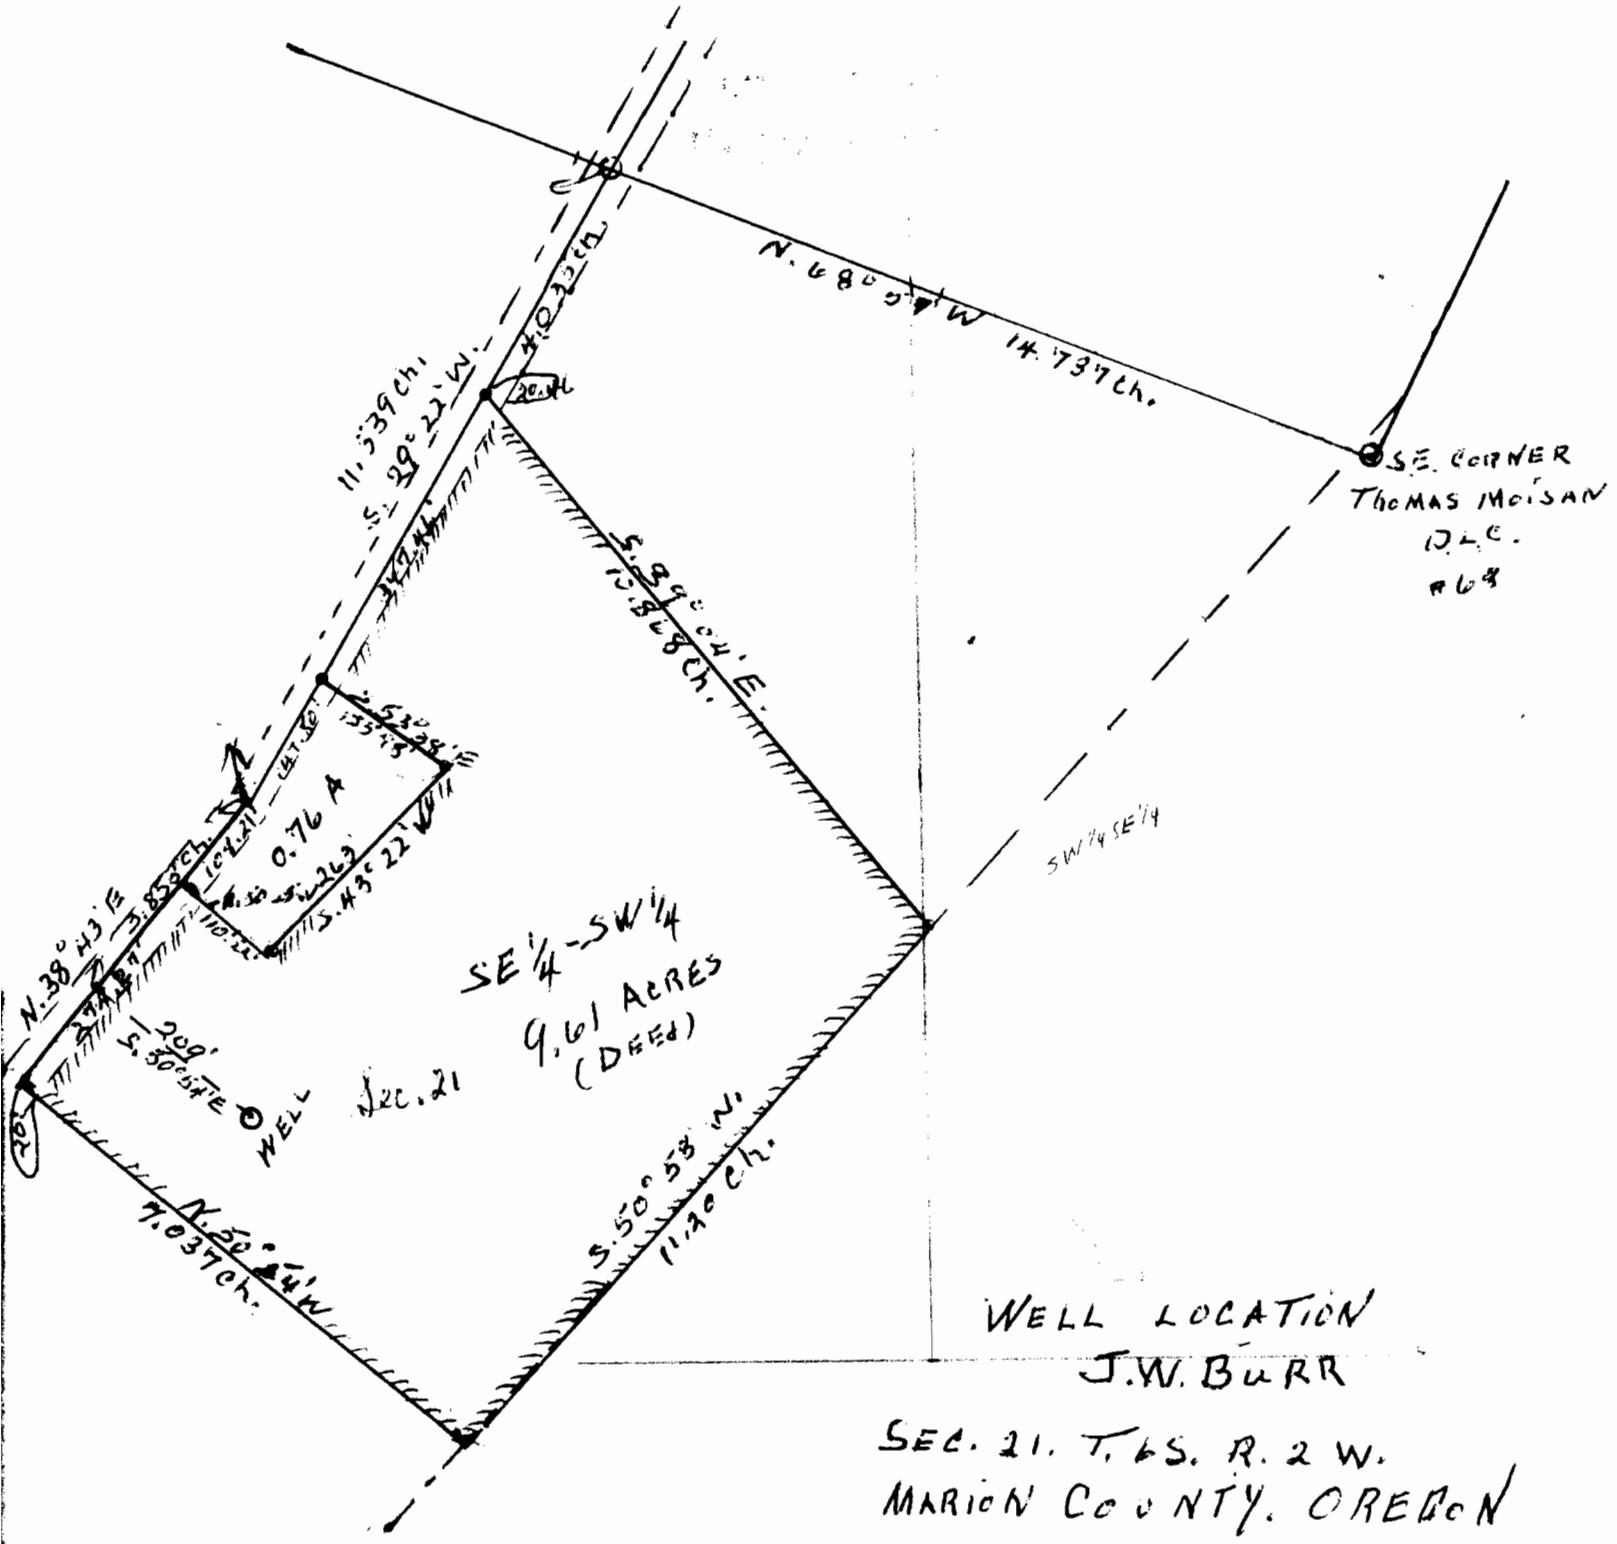

WELL LOCATION
J.W. BURR
SEC. 21. T. 6S. R. 2 W.
MARION COUNTY. OREGON

Application No. G-1192
Permit No. G-962

SCALE 1" = 200'