


T. 38 S., R. 7 W., W.M.

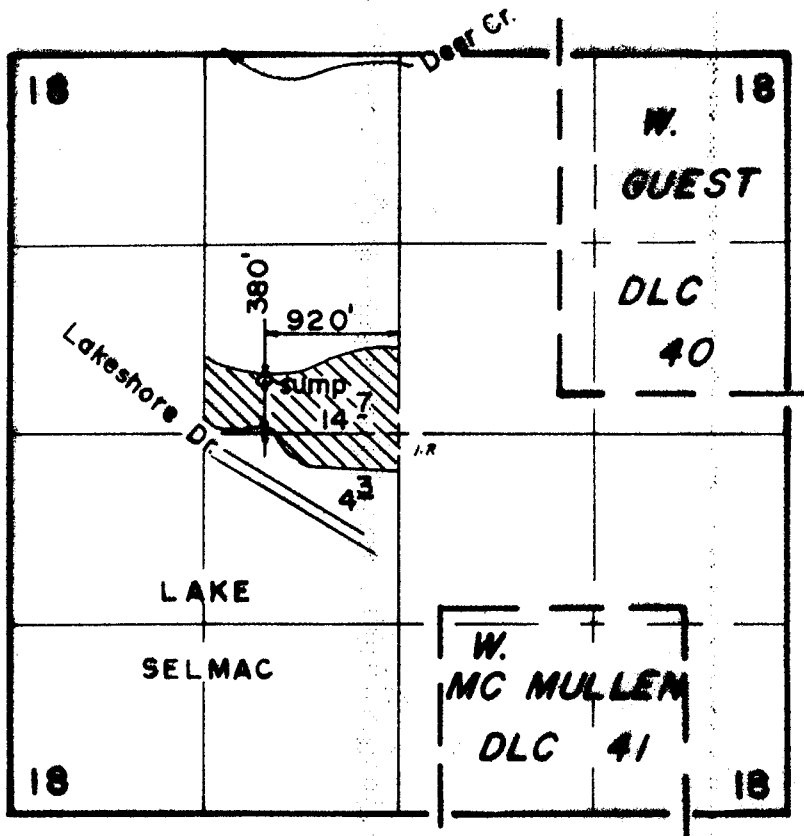

Scale: 1" = 1320'

RECEIVED
FEB 23 1990

WELDON
GRANT

FINAL PROOF SURVEY
UNDER

Application No. G-10372 Permit No. G-9636
IN NAME OF

DOUGLAS BELL WATTS

Surveyed JUN. 11. 1986, by B. S. JAMES