



T.38S., R.11 1/2 E., W.M.

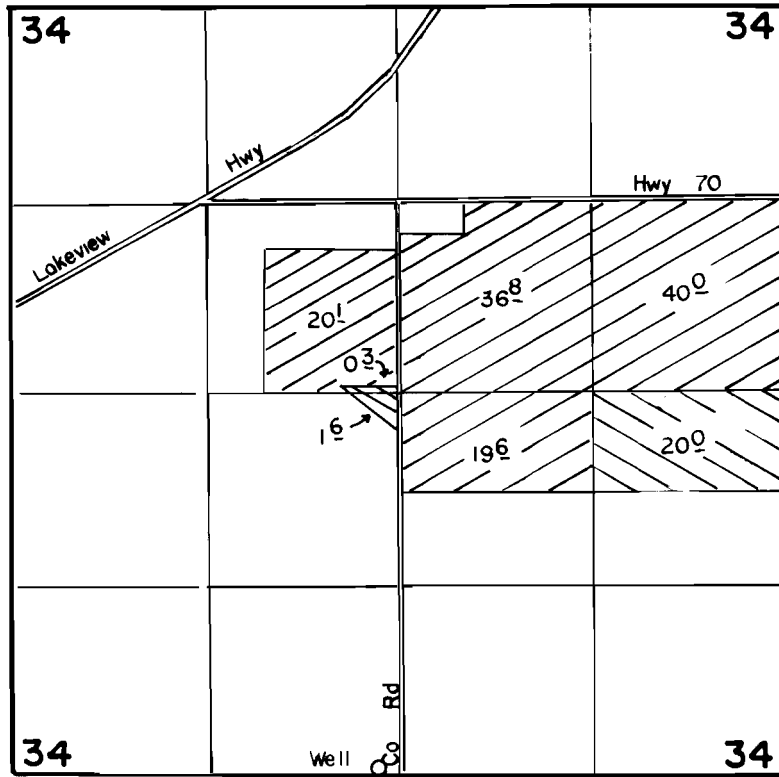

WELL LOC 25' N & 100' W FROM THE S 1/4 COR OF SEC 34

SCALE: 1" = 1320'

**FINAL PROOF SURVEY**  
UNDER

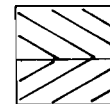

Primary

Supplemental

Application No. G-104.78. Permit No. G-9647.....  
IN NAME OF

..... **URBACH FARMS INC.** .....

Surveyed SEPT. 18... 1989., by B.W. BISHOP.....