


T. 35 S., R. 6 W., W.M.

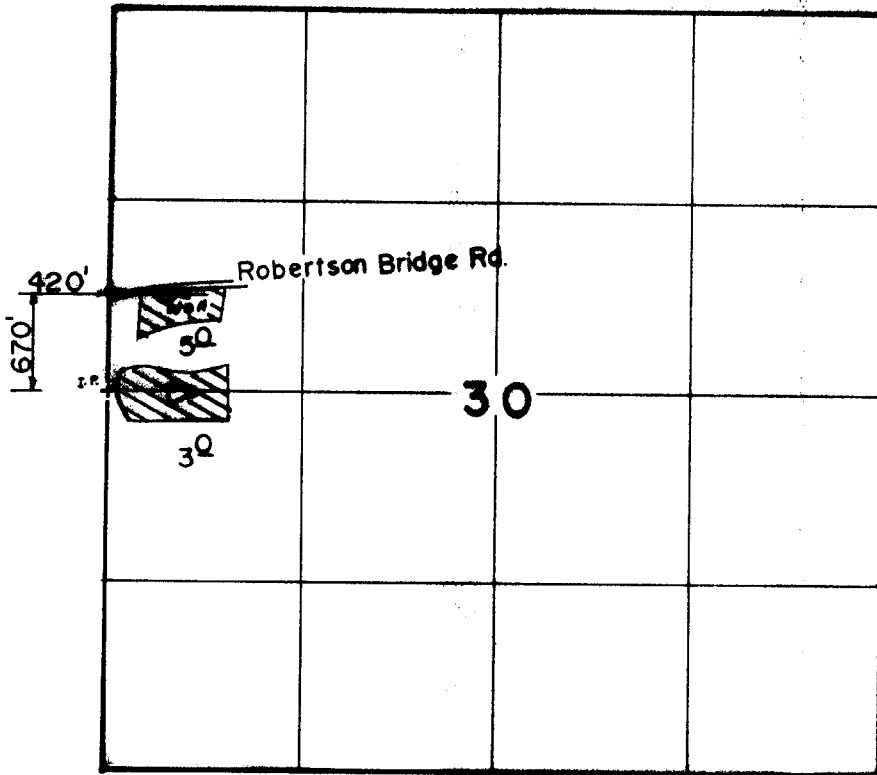

Scale: 1" = 1320'

RECEIVED

MAR 1 1990

WM. DIST. 14
GRANTS PASS, ORE.

FINAL PROOF SURVEY
UNDER

Application No. G-10558 Permit No. G-9649....
IN NAME OF

.....CARL.....W.....REINHARDT.....

Surveyed Q&T....7.... 19.8.7, by B...S.....JAMES..