


J. J.

T. 37 S., R. 6 W., W.M.

RECEIVED

MAR 23 1984

WM. DIST. 14
GRANTS PASS, ORE.

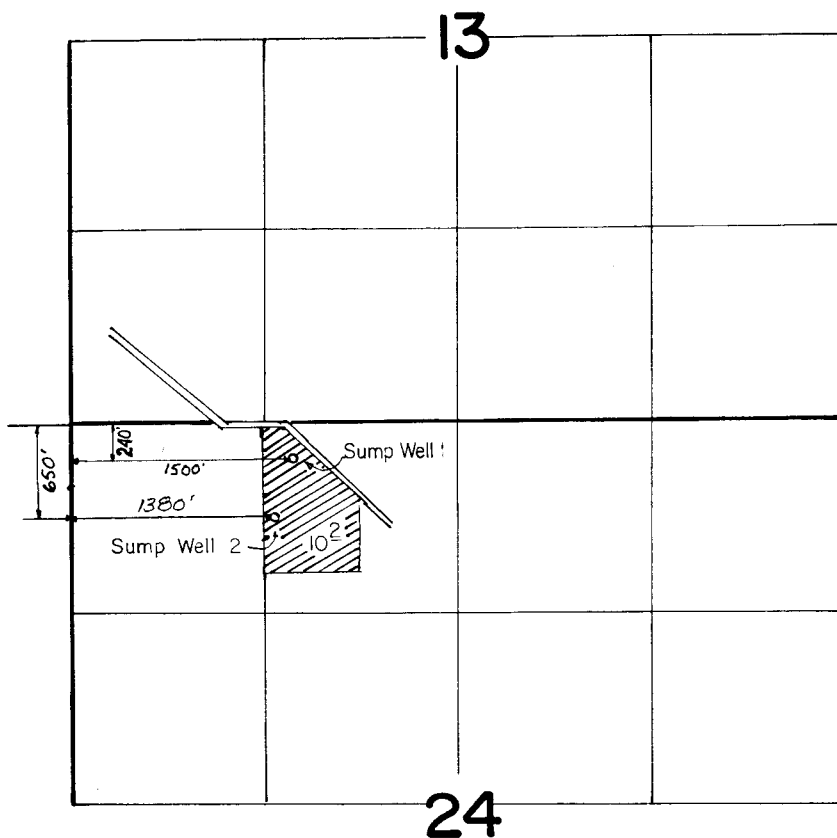

~~FINAL PROOF SURVEY~~
UNDER

Application No. ..G.9699. Permit No. G.9652.....
IN NAME OF

MICHAEL R. GALLAGHER

Surveyed ..OCT. 4, 1983., by .B.S. JAMES.....

70-422 Mc-284