


G-9697
39-5-5

T. 39 S., R. 5 W., W. M.

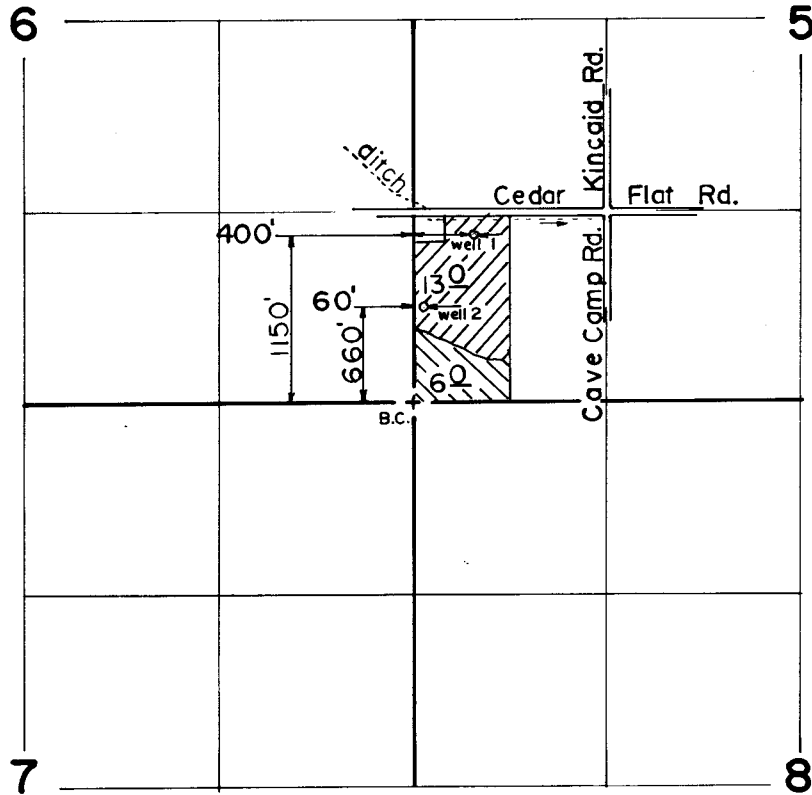

Scale: 1" = 1320'

RECEIVED
OCT 29 1992
WM. DIST. 14
GRANTS PASS, ORE.

FINAL PROOF SURVEY
UNDER

Application No. G-10546 Permit No. G-9697
IN NAME OF

.....ANTHONY A. NEMETH.....

Surveyed JUL...11... 1988, by B. S. JAMES.....

41033-179-87R LMS
4/89