


T. 38 S., R. 5 W., W. M.

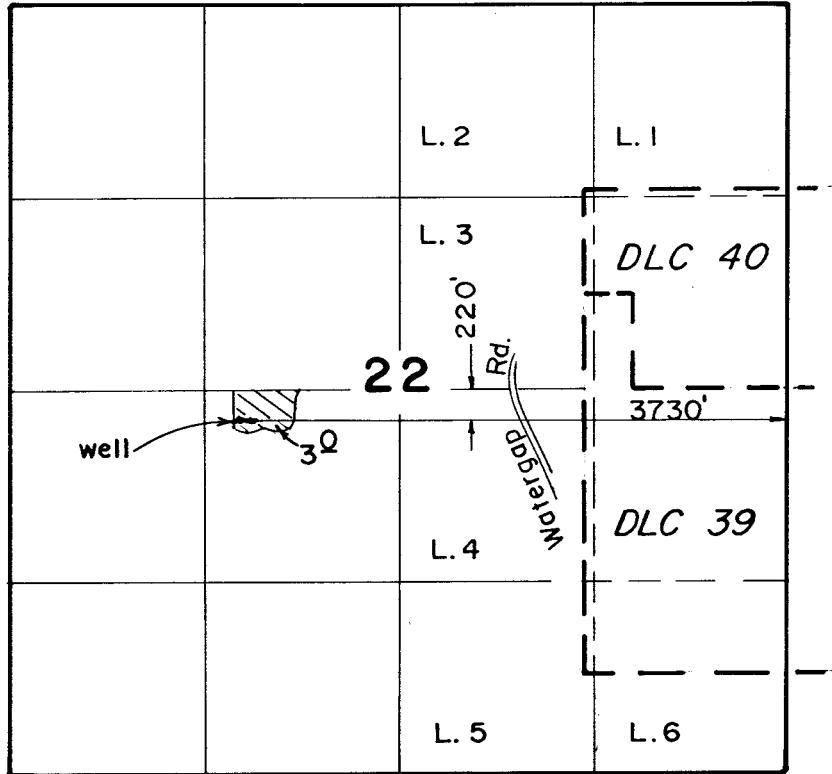

Scale: 1" = 1320'

RECEIVED

AUG 2 1991

WM. DIST. 14
GRANTS PASS, ORE.

FINAL PROOF SURVEY
UNDER

Application No. G-10561. Permit No. G-9700.....
IN NAME OF

FRANK.....N.....&.....ANN.....ADELE.....GLEMBA

Surveyed AUG...11... 1988., by B...S.....JAMES...