


**RECEIVED**

SEE MAP IN 231DA

OCT 21 1981

WATER RESOURCES DEPT  

INITIAL  
CLEMON

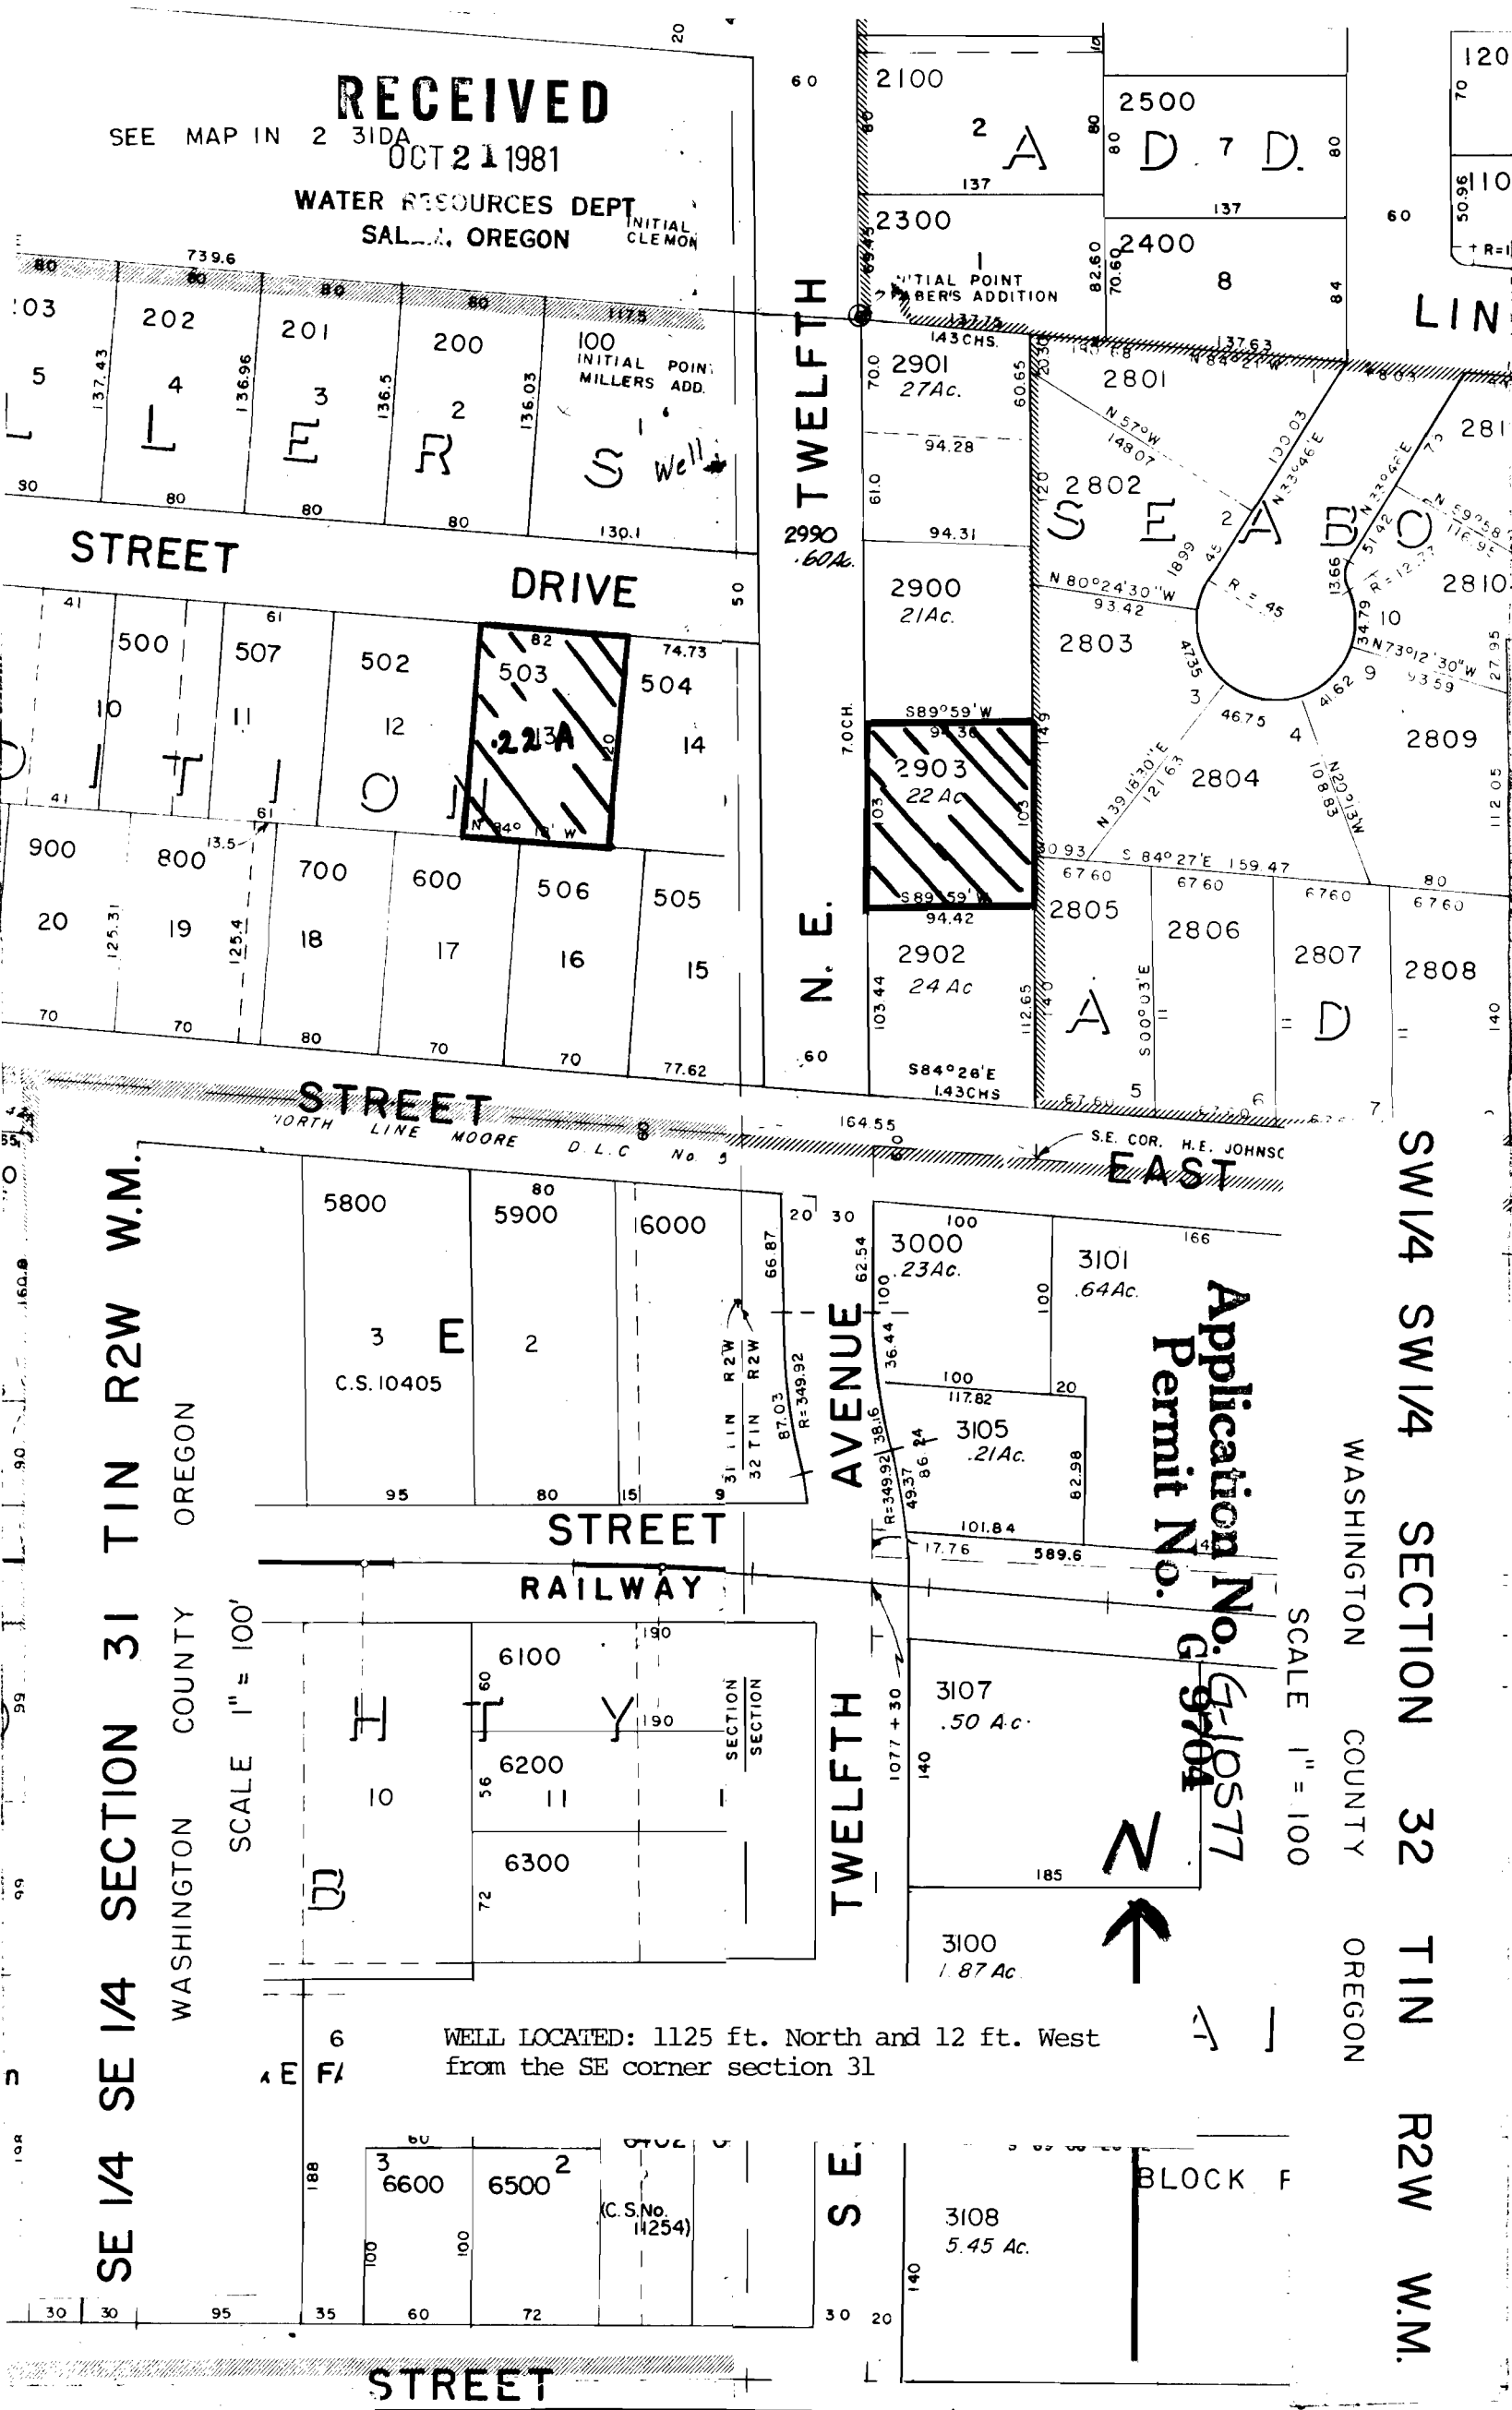

TWELFTH

2990  
.60Ac.

N. E.

AVENUE

TWELFTH

S. E.

Application No. G-10577  
Permit No. G-9704



SCALE 1" = 100'

WELL LOCATED: 1125 ft. North and 12 ft. West from the SE corner section 31

SW 1/4 SW 1/4 SECTION 32 T1N R2W W.M.

SE 1/4 SE 1/4 SECTION 31 T1N R2W W.M.

WASHINGTON COUNTY OREGON

WASHINGTON COUNTY OREGON

SCALE 1" = 100'

STREET

STREET

RAILWAY

EAST

BLOCK F

STREET

100 INITIAL POINT MILLERS ADD.

INITIAL POINT MILLERS ADDITION

Application No. G-10577  
Permit No. G-9704

5800 5900 6000

3 E 2

C.S. 10405

95 80 15

STREET

RAILWAY

SECTION SECTION

6100 6200 6300

10 56 72

SECTION SECTION

6 6

EA FA

188 100 100

3 6600 6500 2

(C.S.No. 11254)

30 30 95 35 60 72

STREET

30 20




2903  
22 Ac.

2902  
24 Ac.

2900  
21 Ac.

2901  
27 Ac.

2801

2802

2803

2804

2805

2806

2807

2808

2809

2810

2811












2500  
D. 7 D.

2400  
8

2300























