


RECEIVED
JAN 4 1932
WATER RESOURCES DEPT.
SALEM, OREGON

T. 36 S. R. 12 E. W.M.

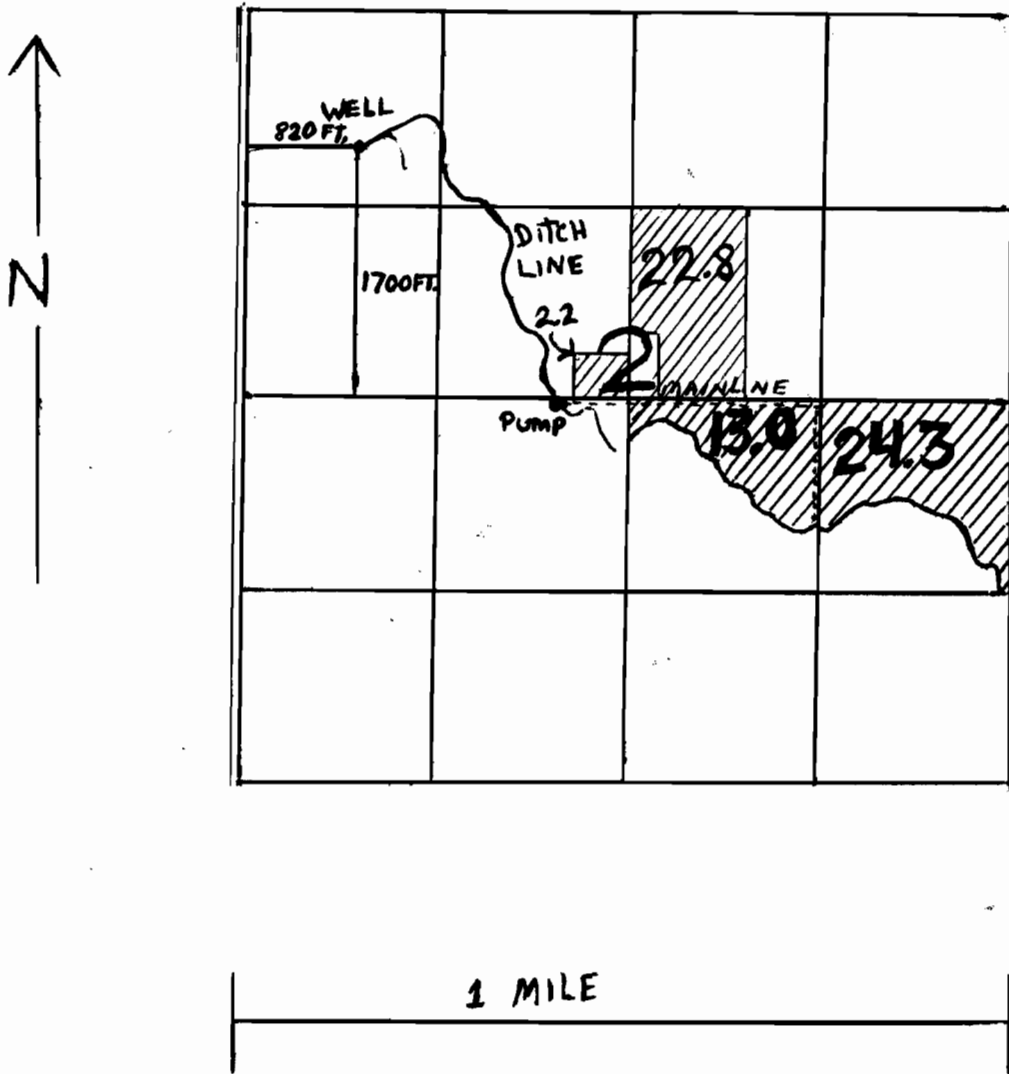

Application No. **G10624**
Permit No. **G 9733**