


RECEIVED
AUG 21 1981
WATER RESOURCES DEPT
SALEM, OREGON

T. 33 S. R. 7 W.

1" = 400'

Application No. G-10525
Permit No. G 9745

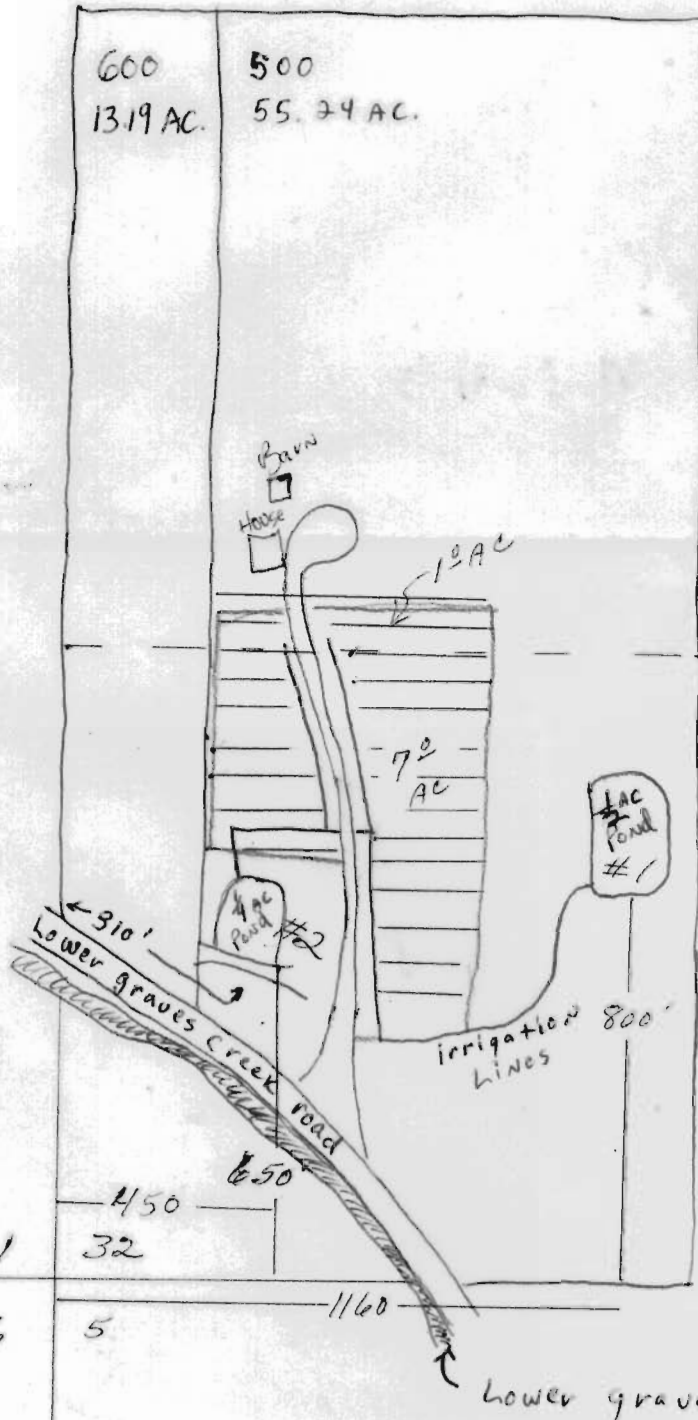

Nick Weber
12799 Lower Graves creek rd
Wolf Creek, Oregon
97497