John P. Ayres

Section 6 T. 1N. R.13E. W.M.

WASCO COUNTY

1" = 400'

RECEIVED
FEB 17 1982
WATER RESOURCES DEPT
SALEM, OREGON

1N 13 6

7-3-78

SEE MAP 2N 13 31

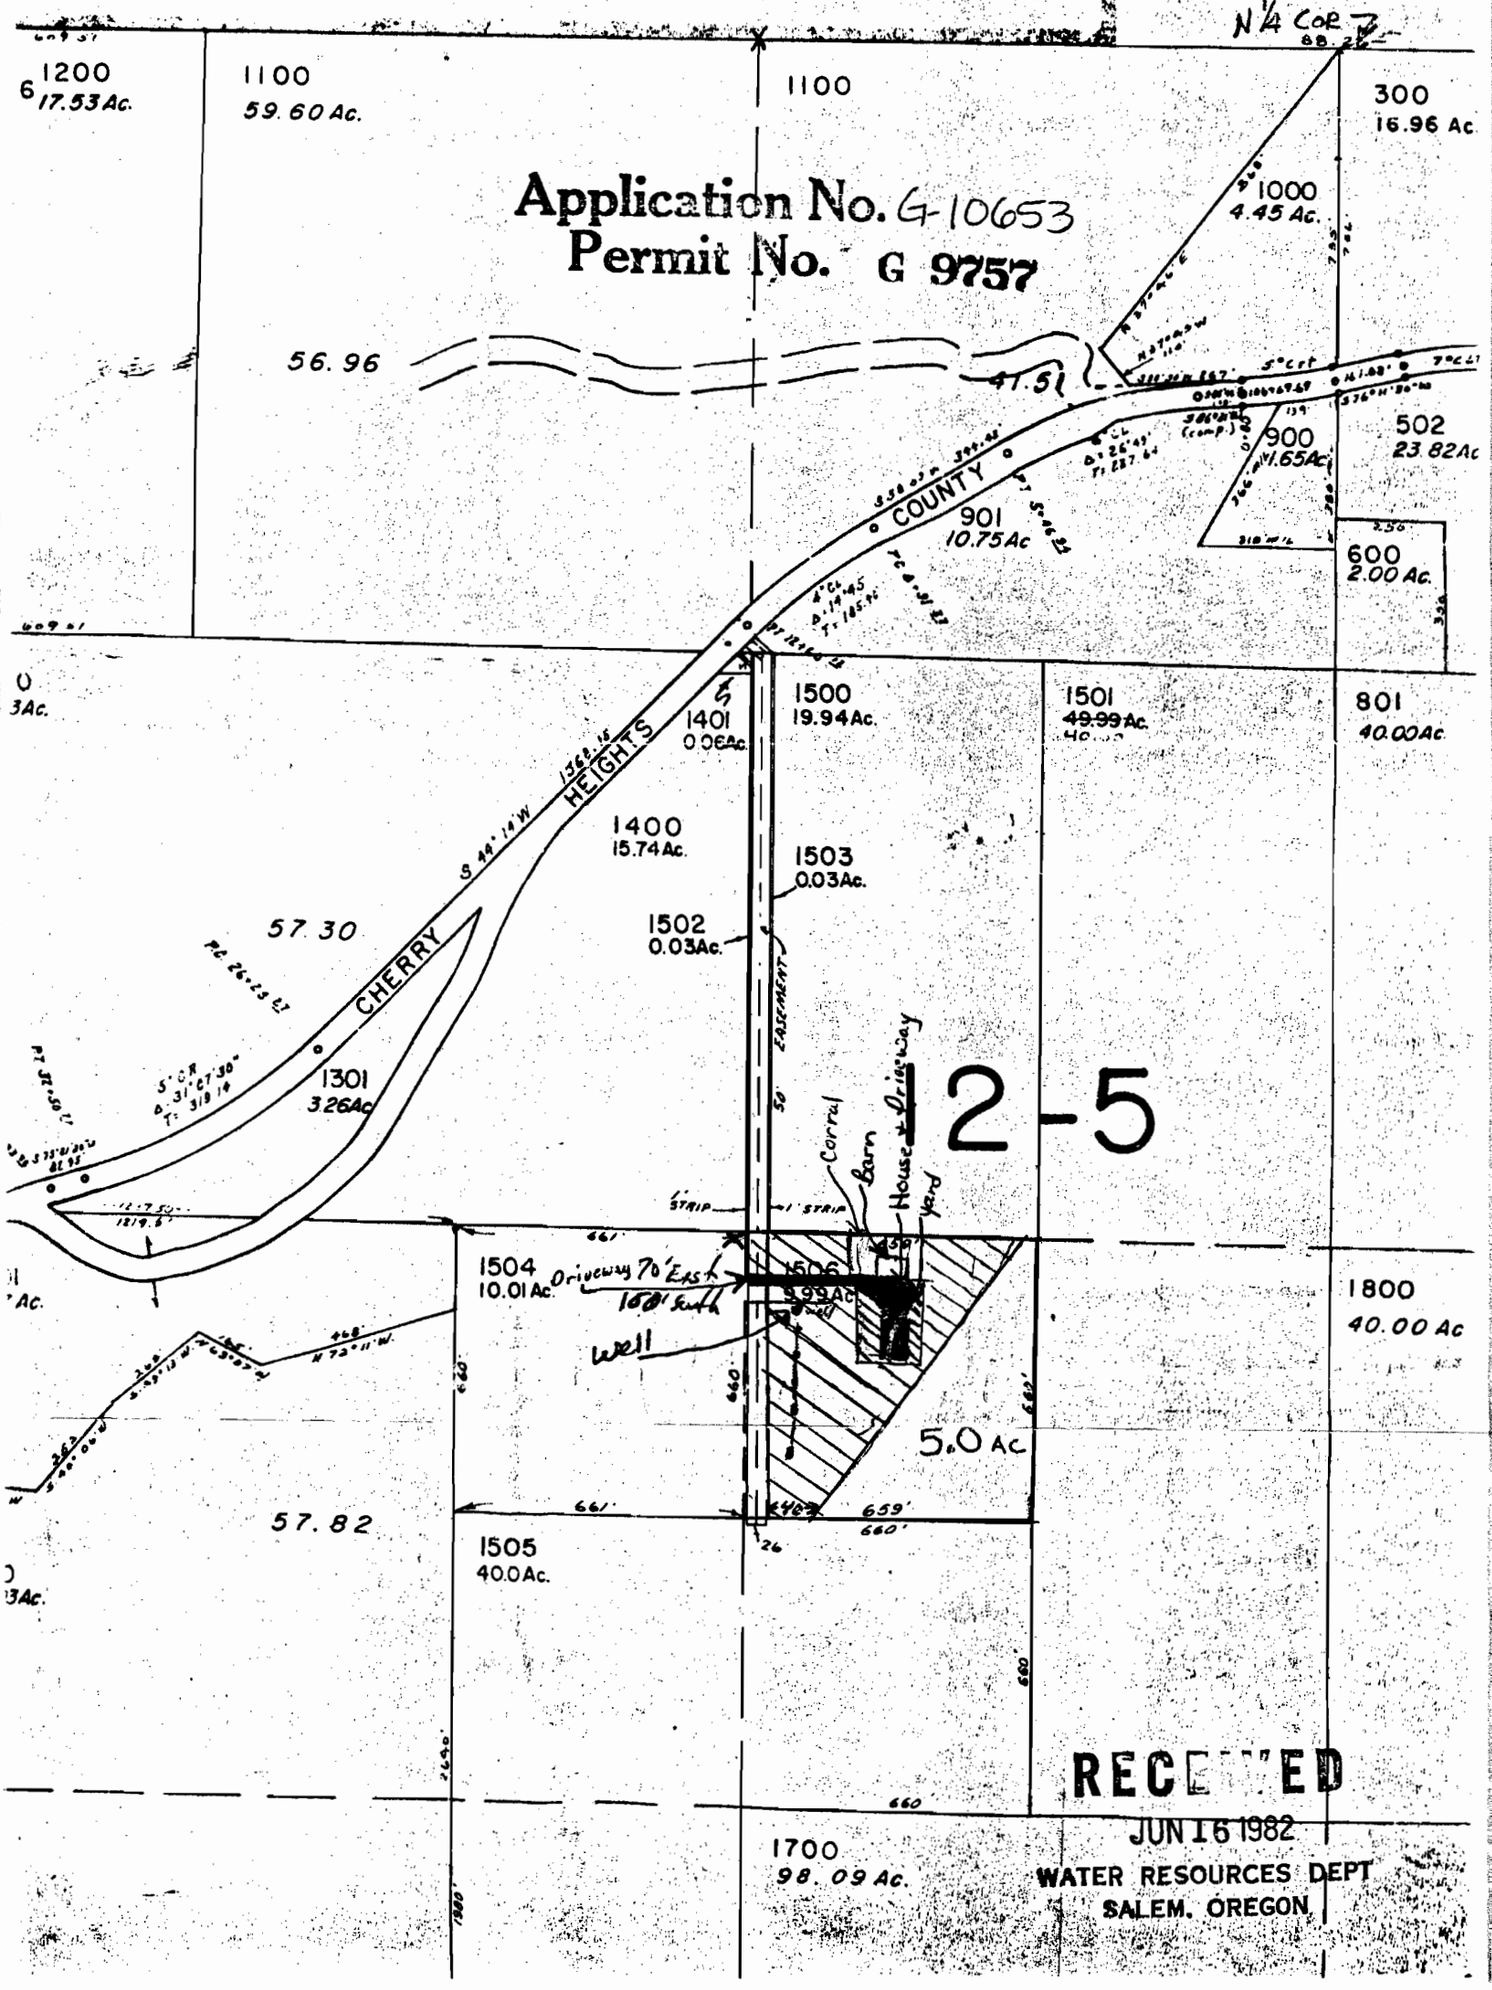

Application No. G-10653
Permit No. G 9757

RECEIVED
JUN 16 1982
WATER RESOURCES DEPT
SALEM, OREGON