


T.19 S.R.44 E.W.M.

Application No. G-10669
Permit No. G 9784

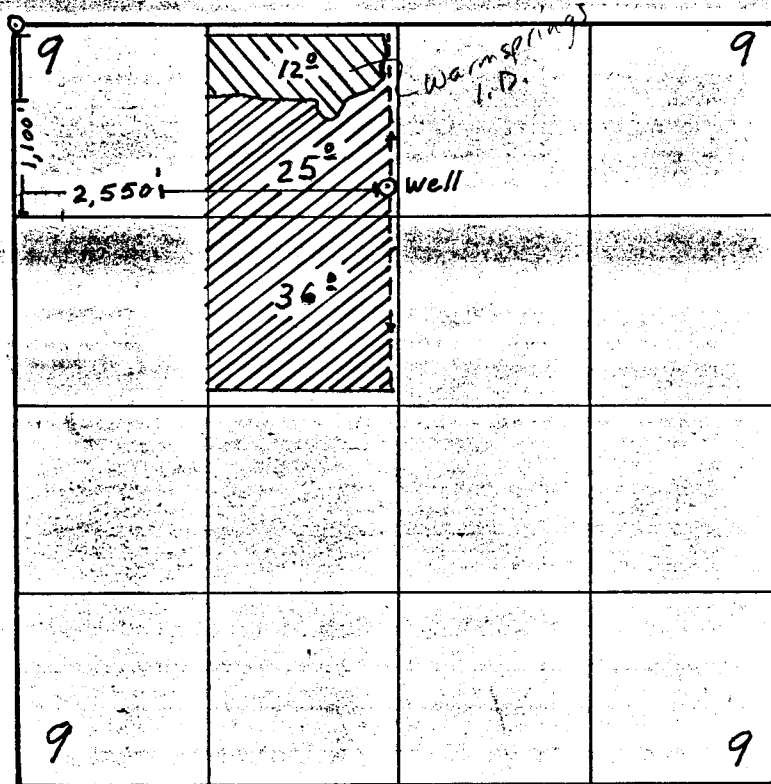

Application map

For

Mario Capaldo

RECEIVED

MAR 15 1982

WATER RESOURCES DEPT
SALTM. OREGON