


Tim R. Marick

Water right for primary water

Well Location

2400 ft N and
390 ft E of the
southeast corner of Sec
24 Township 1 north,
Range 20 east

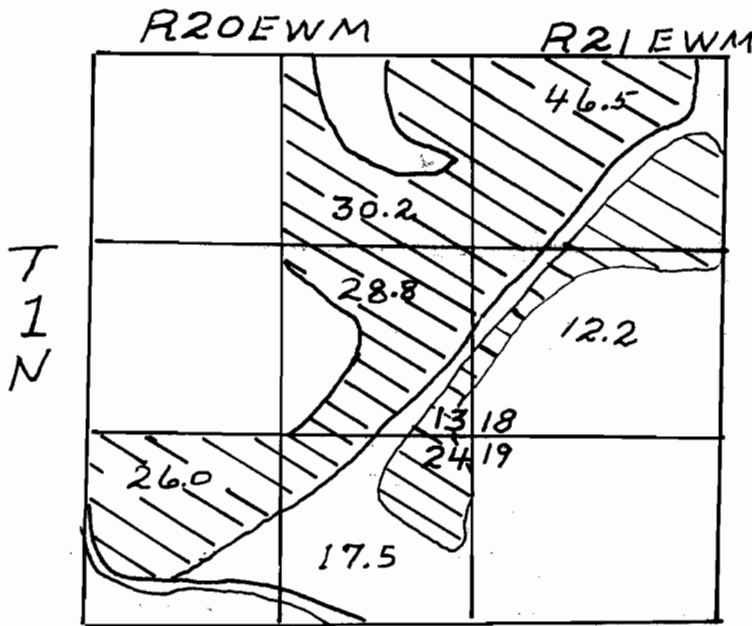

RECEIVED

APR 26 1982

WATER RESOURCES DEPT
SALEM, OREGON

RECEIVED

FEB 13 1982

WATER RESOURCES DEPT
SALEM, OREGON

RECEIVED

JAN 23 1981


WATER RESOURCES DEPT
SALEM, OREGON

Application No. G-10117
Permit No. G 9802

FILE G-10117

Tim R Marick
Star Route
Arlington, Oregon
Gilliam Co.

well location
Sec 19, T 1 N, R 21 EWN

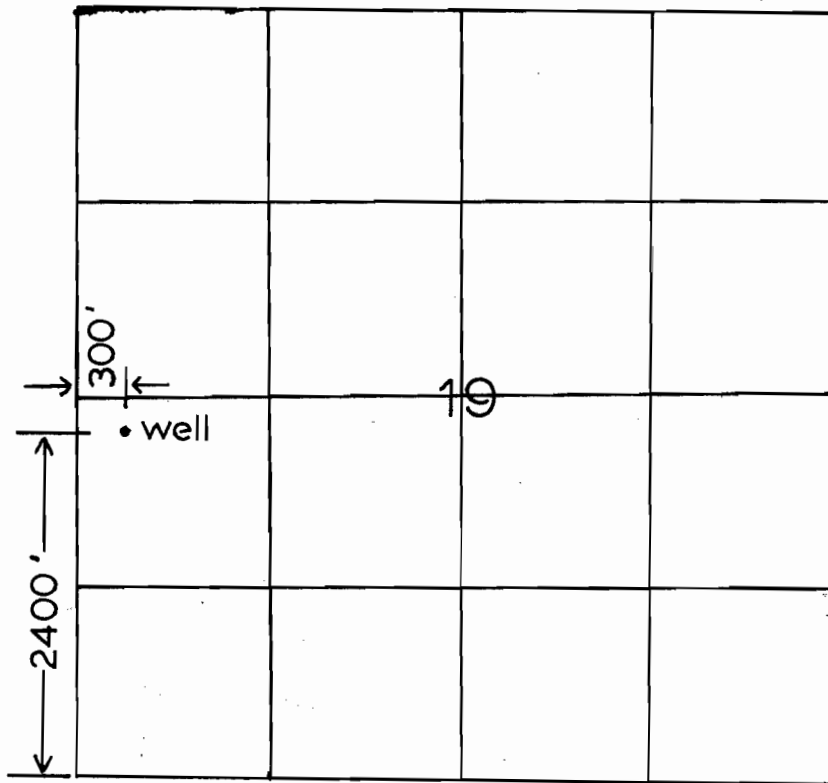

Application No. G-10117
Permit No. G 9802

Scale = 4"/1 mile

RECEIVED
JUL 12 1982
WATER RESOURCES DEPT.
SALEM, OREGON