


# T. 36 S., R. 7 W., W. M.

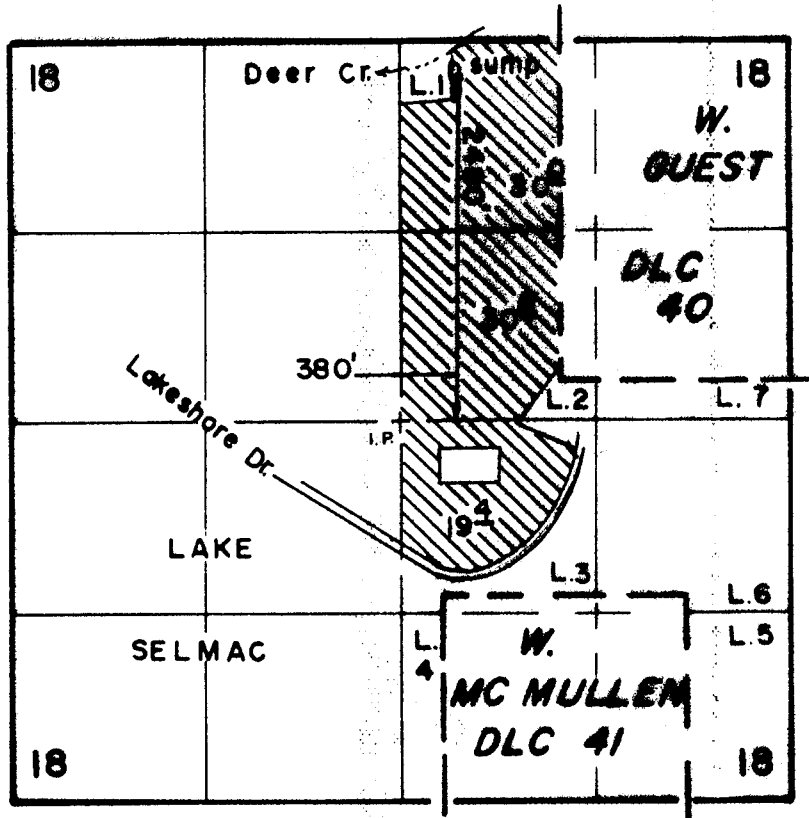

RECEIVED  
 MAR 1 1990  
 WM. DIST. 14  
 GRANTS PASS, ORE.

Scale: 1" = 1320'

## FINAL PROOF SURVEY UNDER

Application No. G-10550 Permit No. G-9806  
IN NAME OF

FOUNDATION OF HUMAN UNDERSTANDING

Surveyed JUN 11 1986, by B. S. JAMES