


T.5 S. R.1 E. W.M.

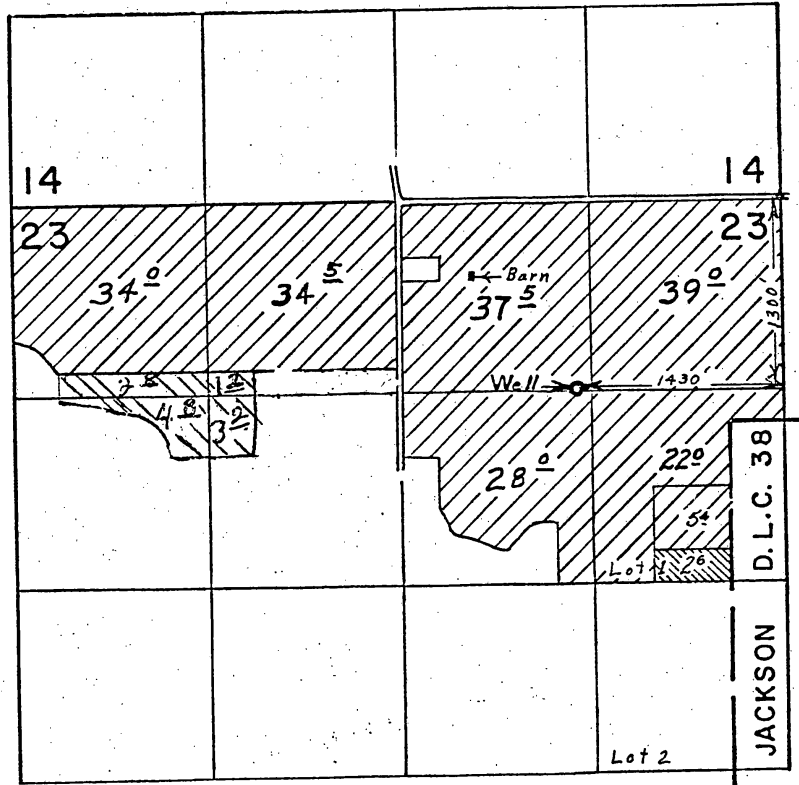

Application No. G-10738
Permit No. G 9818

RECEIVED

JUN 7 - 1982
WATER RESOURCES DEPT.
SALEM, OREGON